

MISSISSIPPI DEPARTMENT OF NATURAL RESOURCES

Bureau of Land and Water Resources

Southport Mall

P.O. Box 10631

Jackson, Mississippi 39209

WATER WELL DRILLERS LOG

JACKSON  
N2104  
8-17-79

COASTAL DRILLING & SERVICE CO. Jackson  
ROUTE #1 BOX 618 county well located

8/17 1979 date well completed

LANDOWNER: East Sherman MILOXI, MISS. 39532  
Short Cut Rd  
Olean Spring Miss  
(mailing address)

description of formations encountered	from	to
top soil	1	3
Red Clay	3	15
gray sand	15	35
coarse white sand	35	80
soft blue clay	80	275
fine white sand	275	300
thick blue clay	300	360
fine white sand	360	370
light water sand	370	400

WELL LOCATION:

sec. 23 T 2 N R 8 E  
2 1/2 NE mile Olean Spring  
(distance) (direction) (nearest town)

WELL PURPOSE: home  
(home, irrigation, municipal, industrial)

WELL COMPLETION DATA:

- (1) diameter (inches) 2"
- (2) total depth (feet) 400'
- (3) static water level (feet) 40' below top of ground.
- (4) casing PVC 390' (material) (depth)
- (5) screen 10' 390' (length) (depth to top)
- (6) pump 1 1/2 (HP) 14 (yield gpm)
- (7) electric log (type power) (yes or no)

(organization running log)

(8) how well bottom plugged  
2' thick water valve

DRILLERS REMARKS: 19-B


DEPT. OF NATURAL RESOURCES  
BUREAU OF LAND & WATER RESOURCES

NOV - 3 1980

RECEIVED

If well telescopes, please sketch and show depths.

GROUND LEVEL

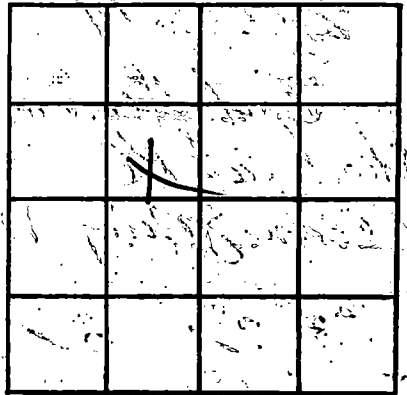

SECTION \_\_\_\_\_

Please indicate well location X.

ADDITIONAL INFORMATION

If more than one screen, show locations of each on sketch.