

MISSISSIPPI DEPARTMENT OF NATURAL RESOURCES

Bureau of Land and Water Resources

Southport Mall

P.O. Box 10631

Jackson, Mississippi 39209

WATER WELL DRILLERS LOG

COASTAL DRILLING & SERVICE CO.

ROUTE 1 BOX 618

BOLOM, MISS. 39532

county well located

JACKSON

N 2107

10/23/79

date well completed

LANDOWNER

Rt 6

Olean Spring Min
(mailing address)

WELL LOCATION:

sec. 3 T 7 N R 9 E

W 1/4
1/4 mile (distance) of (direction) (nearest town)

WELL PURPOSE:

(home, irrigation, municipal, industrial)

WELL COMPLETION DATA:

(1) diameter (inches) 2"
(2) total depth (feet) 450'
(3) static water level (feet) 35' (below top of ground)

(4) casing 4" (material) 440' (depth)

(5) screen 10' (length) 440' (depth to top)
2" (size) 4" (material)

(6) pump 1/2 HP (HP) 13 (yield gpm)
Ele (type power)

(7) electric log no (yes or no)

(organization running log)

(8) how well bottom plugged
2" backwash valve

DRILLERS REMARKS: 19-B

description of formations encountered

from to

top soil	1	3
Red Clay	3	15
Sugar Sand	15	40
Self Blue Clay	40	210
Red Blue Clay	210	320
fine water sand	320	340
Hard Blue Clay	340	390
fine water sand	390	410
Grth water sand	410	450


DEPT. OF NATURAL RESOURCES
BUREAU OF LAND & WATER RESOURCES

NOV - 9 1980

RECEIVED

If well telescopes please
sketch and show depths.

GROUND LEVEL

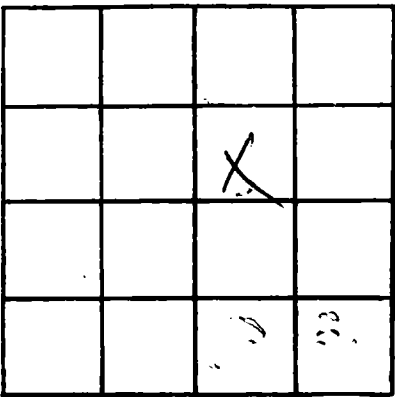

SECTION _____

Please indicate well location X.

ADDITIONAL INFORMATION

If more than one screen,
show locations of each on sketch.