

JACKSON  
 N 210  
 7-14-78

MISSISSIPPI  
 BOARD OF WATER COMMISSIONERS  
 416 North State Street  
 Jackson, Mississippi 39201

WATER WELL DRILLERS LOG

*Jackson*  
~~Hamilton~~

July 14 1978 date well completed  
 McMill Well Inc. firm name  
 county well located

LANDOWNER: M.E. Cochran  
 1303 Hillcrest Rd.  
 Ocean Springs, Ms.  
(mailing address)

description of formations encountered	from	to
	sand	0

WELL LOCATION:  
 sec. 13 T 7 N R 9 E  
 2 miles S of Mince  
(distance) (direction) (nearest town)

WELL PURPOSE:  
(home, irrigation, municipal, industrial)

- WELL COMPLETION DATA:
- (1) diameter (inches) 2"
  - (2) total depth (feet) 50'
  - (3) static water level (feet) 4' below top of ground
  - (4) casing Sch. 40 40  
(material) (depth)  
 If telescope see back.
  - (5) screen 10'  
(length) (depth to top)  
 2" Sch. 40  
(size) (material)
  - (6) pump 1/2 15  
(HP) (yield gpm)  
 Electric  
(type power)
  - (7) electric log no  
(yes or no)  
(organization running log)
  - (8) how well bottom plugged Capped

DRILLERS REMARKS:


Miss. Board of Water Comm.

JUN 21 1979

RECEIVED

If well telescopes please sketch and show depths.

GROUND LEVEL

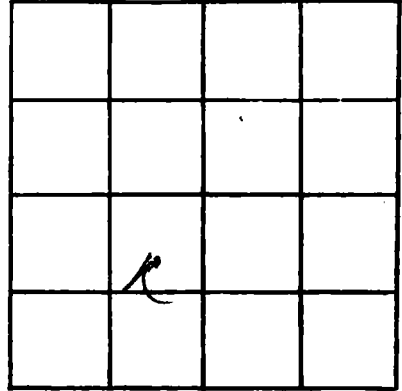

SECTION 13

Please indicate well location X.

ADDITIONAL INFORMATION

If more than one screen, show locations of each on sketch.