

JACKSON
 N 2111
 3-30-79
 3/30/79
 date well completed

MISSISSIPPI
 BOARD OF WATER COMMISSIONERS
 416 North State Street
 Jackson, Mississippi 39201

WATER WELL DRILLERS LOG
 COASTAL DRILLING & SERVICE CO.

ROUTE 1 BOX 618
 firm name
 BILOXI MISS. 39532
 county well located

LANDOWNER: *Side Howard*
Douglas Vestry Road
Belmont, Miss
 (mailing address)

description of formations encountered	from	to
<i>top soil</i>	<i>1</i>	<i>2</i>
<i>red clay</i>	<i>2</i>	<i>9</i>
<i>white sand</i>	<i>9</i>	<i>25</i>
<i>red clay</i>	<i>25</i>	<i>60</i>
<i>super sand</i>	<i>60</i>	<i>60</i>
<i>soft blue clay</i>	<i>60</i>	<i>110</i>
<i>super sand</i>	<i>110</i>	<i>180</i>
<i>soft blue clay</i>	<i>180</i>	<i>270</i>
<i>white sand</i>	<i>270</i>	<i>300</i>
<i>hard blue clay</i>	<i>300</i>	<i>390</i>
<i>white sand</i>	<i>390</i>	<i>400</i>
<i>base sand</i>	<i>400</i>	<i>433</i>

WELL LOCATION:
 sec. *3* T. *7* N. R. *9* E
(2) 1/2 miles South of *Latimer*
 (distance) (direction) (nearest town)

WELL PURPOSE: *home*
 (home, irrigation, municipal, industrial)

- WELL COMPLETION DATA:
- (1) diameter (inches) *4 1/2"*
 - (2) total depth (feet) *433'*
 - (3) static water level (feet) *100* (below above top of ground)
 - (4) casing *pvc* *4 1/2"* (material) (depth)
4 1/2" (size) If telescope see back.
 - (5) screen *15'* *4 1/2"* (length) (depth to top)
2" (size) *pvc* (material)
 - (6) pump *one* *16* (HP) (yield gpm)
3hp sch (type power)
 - (7) electric log *no* (yes or no)
- (organization running log)

(8) how well bottom plugged
2" gravel with tubes

DRILLERS REMARKS: *19-B*

Miss. Board of Water Comm

JUN 15 1979

RECEIVED

If well telescopes please sketch and show depths.

GROUND LEVEL


160' 4" PK Casing

258' 2" PK Casing

15' 2" PK Casing

2" back wash valve

If more than one screen, show locations of each on sketch.

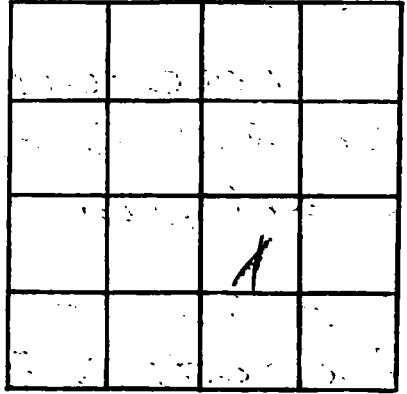

SECTION _____

Please indicate well location X.

ADDITIONAL INFORMATION

Handwritten notes at the bottom of the grid section, including "2-19" and other illegible scribbles.