

JACKSON
 N 219
 6-14-79

MISSISSIPPI
 BOARD OF WATER COMMISSIONERS
 416 North State Street
 Jackson, Mississippi 39201

WATER WELL DRILLERS LOG

6-14-1979 date well completed
 79 Coast Water Well Serv. Inc. firm name
 Jackson county well located

LANDOWNER	description of formations encountered	from	to
Herman Tacon 14405 Cullen St.	Sandy Top soil	0	5
Biloxi, Miss. 39532 (mailing address)	Red Clay	5	18
WELL LOCATION: sec 12 T 7 R 9 2 miles North Ocean Springs (distance) (direction) (nearest town)	gray Clay	18	45
WELL PURPOSE: Home (home, irrigation, municipal, industrial)	Sand C	45	65
WELL COMPLETION DATA: (1) diameter (inches) 2" (2) total depth (feet) 46.5' (3) static water level (feet) 80' below top of ground (4) casing PVC 455' (material) (depth) 2" (size) If telescope see back. (5) screen 10' 455' (length) (depth to top) 2" PVC (size) (material) (6) pump 2 h.p. 6- (HP) (yield gpm) Elex (type power) (7) electric log No (yes or no) (organization running log) (8) how well bottom plugged Back Wash Valve	Blue Clay	65	164
	Sand LF	164	178
	Blue Clay	178	415
	Sand C	415	46.5

DEPT. OF NATURAL RESOURCES
 BUREAU OF LAND & WATER RESOURCES


JAN 25 1980

RECEIVED

DRILLERS REMARKS:

If well telescopes please sketch and show depths.

GROUND LEVEL

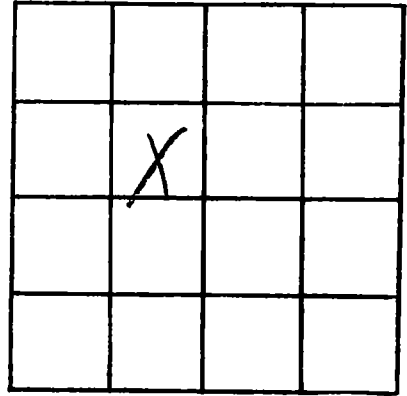

SECTION 102

Please indicate well location X.

ADDITIONAL INFORMATION

If more than one screen,
show locations of each on sketch.