

JACKSON
N 2121
2-19-80

MISSISSIPPI
BOARD OF WATER COMMISSIONERS
416 North State Street
Jackson, Mississippi 39201

WATER WELL DRILLERS LOG

Feb. 19 1980 *Duncan Well Drilling Jackson*
date well completed firm name county well located

LANDOWNER: <i>Gene Boat Drillers</i>	description of formations encountered	from	to
<i>Lucker Road</i>			
<i>Ocean Springs, Mo.</i> (mailing address)	<i>Clay</i>	<i>0</i>	<i>60</i>
	<i>Sand</i>	<i>60</i>	<i>80</i>

WELL LOCATION:
sec. *36* T. *6* N. R. *9* E
4 miles (distance) *S.W.* (direction) of *Oshtemo* (nearest town)

WELL PURPOSE:
(home, irrigation, municipal, Industrial)

- WELL COMPLETION DATA:
- (1) diameter (Inches) *80'*
 - (2) total depth (feet) *2m*
 - (3) static water level (feet) *8'* below top of ground
 - (4) casing *pvc*, *70'*
(material) (depth)
2" (size) if telescope see back.
 - (5) screen *10'*, *70'*
(length) (depth to top)
2" (size) *pvc* (material)
 - (6) pump *1/2*, *10*
(HP) (yield gpm)
electric (type power)
 - (7) electric log _____
(yes or no)
 - (organization running log) _____

(8) how well bottom plugged *Sand*
Mark

DRILLERS REMARKS:


DEPT. OF NATURAL RESOURCES
BUREAU OF LAND & WATER RESOURCES

MAY 16 1980

RECEIVED

If well telescopes please sketch and show depths.

GROUND LEVEL

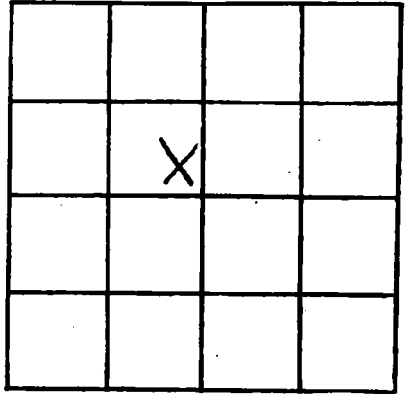

SECTION 36

Please indicate well location X.

ADDITIONAL INFORMATION

If more than one screen,
show locations of each on sketch.