

MISSISSIPPI DEPARTMENT OF NATURAL RESOURCES

Bureau of Land and Water Resources

Southport Mall

P.O. Box 10631

Jackson, Mississippi 39209

WATER WELL DRILLERS LOG

COASTAL DRILLING & SERVICE CO. *Jackson*

ROUTE # *1* near *BOX 618*

county well located

JACKSON
N 2125
11-23-79

date well completed *11/23/79*

LANDOWNER *Fred Spell* BILOXI MISS 39532

description of formations encountered

from to

Short Cut Rd
Dean Spring Min
(mailing address)

<i>Top Soil</i>	<i>1</i>	<i>3</i>
<i>Red Clay</i>	<i>3</i>	<i>18</i>
<i>Sugar Sand + logs</i>	<i>18</i>	<i>60</i>
<i>Coarse white sand</i>	<i>60</i>	<i>90</i>
<i>Soft Blue Clay</i>	<i>90</i>	<i>210</i>
<i>Hard Blue Clay</i>	<i>210</i>	<i>340</i>
<i>fine water sand</i>	<i>340</i>	<i>360</i>
<i>Coarse water sand</i>	<i>360</i>	<i>390</i>

WELL LOCATION:

sec *E3-T-7-N* R *8-E*
2 1/2 miles *SE* *Dean Spring*
(distance) (direction) (nearest town)

WELL PURPOSE: *Home*
(home, irrigation, municipal, industrial)

WELL COMPLETION DATA:

- (1) diameter (inches) *2"*
- (2) total depth (feet) *390'*
- (3) static water level (feet) *35'* below above top of ground.
- (4) casing *PVC*, *380'*
(material) (depth)
(size) If telescope see back.
- (5) screen *10'*, *380'*
(length) (depth to top)
2"
(size) *PVC*
(material)
- (6) pump *one*, *14*
(HP) (yield gpm)
Electric
(type power)
- (7) electric log *no*
(yes or no)
(organization running log)

DEPT. OF NATURAL RESOURCES
BUREAU OF LAND & WATER RESOURCES


NOV - 5 1980

RECEIVED

(8) how well bottom plugged *2" lead (wash) below*
DRILLERS REMARKS: *19-B*

If well telescopes please sketch and show depths.

GROUND LEVEL

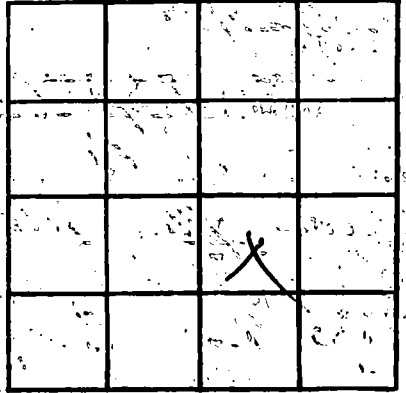

SECTION _____

Please indicate well location X.

ADDITIONAL INFORMATION

If more than one screen,
show locations of each on sketch.