

MISSISSIPPI DEPARTMENT OF NATURAL RESOURCES

Bureau of Land and Water Resources

Southport Mall

P.O. Box 10631

Jackson, Mississippi 39209

WATER WELL DRILLERS LOG  
COASTAL DRILLING & SERVICE CO.

JACKSON  
N 2128  
6-21-80  
6/21/80

date well completed 19

ROUTE 1 BOX 618

firm name BILOXI, MISS. 39532

Jackson  
county well located

LANDOWNER *Am Totale*

description of formations encountered

from to

*L & W Lead*

<i>top soil</i>	<i>1</i>	<i>3</i>
<i>white sand</i>	<i>3</i>	<i>15</i>
<i>5 ft Blue Clay</i>	<i>15</i>	<i>60</i>
<i>green sand</i>	<i>60</i>	<i>90</i>
<i>5 ft Blue Clay</i>	<i>90</i>	<i>210</i>
<i>hard Blue Clay</i>	<i>210</i>	<i>280</i>
<i>fine white sand</i>	<i>280</i>	<i>300</i>

*Biledi Min*  
(mailing address)

WELL LOCATION:

sec. *15* T. *7* N. R. *9* W.

*O'Heaville*  
(distance) miles (direction) of (nearest town)

WELL PURPOSE: *home*  
(home, irrigation, municipal, industrial)

WELL COMPLETION DATA:

- (1) diameter (inches) *2"*
- (2) total depth (feet) *300*
- (3) static water level (feet) *30'* <sup>below</sup> ~~above~~ top of ground.
- (4) casing *PVC* *290'*  
(material) (depth)  
(size) if telescope see back.
- (5) screen *10'* *290'*  
(length) (depth to top)  
*2"* *PVC*  
(size) (material)
- (6) pump *one* *15*  
(HP) (yield gpm)  
*gle*  
(type power)
- (7) electric log *no*  
(yes or no)

(organization running log)

(8) how well bottom plugged  
*3 inch water table*

DRILLERS REMARKS:


DEPT. OF NATURAL RESOURCES  
BUREAU OF LAND & WATER RESOURCES

JAN 23 1981

RECEIVED

If well telescopes please  
sketch and show depths.

GROUND LEVEL

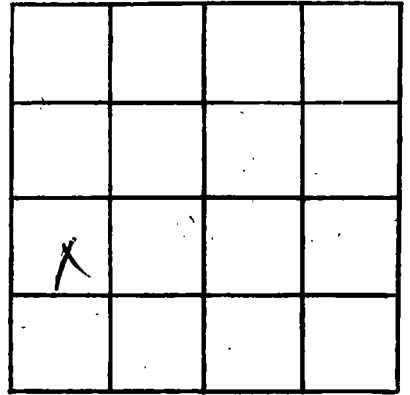

SECTION \_\_\_\_\_

Please indicate well location X.

ADDITIONAL INFORMATION

If more than one screen,  
show locations of each on sketch.