

MISSISSIPPI DEPARTMENT OF NATURAL RESOURCES

Bureau of Land and Water Resources

Southport Mall

P.O. Box 10631

Jackson, Mississippi 39209

WATER WELL DRILLERS LOG
COASTAL DRILLING & SERVICE CO.

ROUTE 1 BOX 618

firm name
BILOXI MISS. 39532

county well located

JACKSON
N 2129

7-12-80

7/12/80

date well completed

LANDOWNER

Spartan Lodge

description of formations encountered

from

to

Old Hwy 90

Top Soil

1

4

Ocean Springs, Miss
(mailing address)

Shells + Clay bedded

4

22

Coarse white sand

22

65

Soft Blue Clay

65

190

fine water sand

190

220

Soft Blue Clay

220

310

hard Blue Clay

310

460

fine water sand

460

500

good water sand

500

530

WELL LOCATION:

sec. 19 T. 2 N. R. 8 E.
Shell Hill Refuge
(distance) (direction) (nearest town)

WELL PURPOSE:

(home, irrigation, municipal, industrial)

WELL COMPLETION DATA:

- (1) diameter (inches) 2"
- (2) total depth (feet) 530'
- (3) static water level (feet) 30' ^{below} top of ground.
- (4) casing PVC 520'
(material) (depth)
- (size) if telescope see back.
- (5) screen 10' 520'
(length) (depth to top)
- 2" PVC
(size) (material)
- (6) pump one 12
(HP) (yield gpm)
- etc
(type power)
- (7) electric log no
(yes or no)

(organization running log)

(8) has well bottom plugged

2' back with valve

DRILLERS REMARKS:


DEPT. OF NATURAL RESOURCES
BUREAU OF LAND & WATER RESOURCES

JAN 2 1981

RECEIVED

If well telescopes please sketch and show depths.

GROUND LEVEL

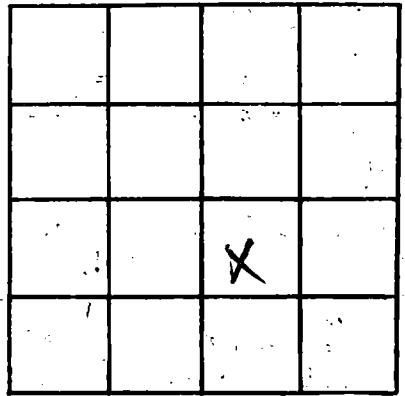

SECTION _____

Please indicate well location X.

ADDITIONAL INFORMATION

A series of horizontal lines for writing additional information.

If more than one screen, show locations of each on sketch.