

MISSISSIPPI DEPARTMENT OF NATURAL RESOURCES

Bureau of Land and Water Resources

Southport Mall

P.O. Box 10631

Jackson, Mississippi 39209

WATER WELL DRILLERS LOG
COASTAL DRILLING & SERVICE CO.

JACKSON
N 2130

7-28-80

7/28/80

ROUTE 1 BOX 618

BILOXI MISS. 39532

Jackson
county well located

LANDOWNER:

description of formations encountered

from to

Fort Reynolds
Ocean Spring Min
(mailing address)

top soil	1	3
Red clay	3	20
Sugar sand	20	45
Soft Blue Clay	45	210
hard Blue Clay	210	240
good water sand	240	264

WELL LOCATION:

sec 3 T 2 N R 8 E
(3) 1/4 NE Ocean Spring
(distance) (direction) (nearest town)

WELL PURPOSE:

(home, irrigation, municipal, industrial)

WELL COMPLETION DATA:

- (1) diameter (inches) 2"
- (2) total depth (feet) 264'
- (3) static water level (feet) 40' below top of ground
- (4) casing PVC 2 1/2" (material) (depth)
- (5) screen 10' 2 1/2" (length) (depth to top) (size) (material)
- (6) pump One (HP) 14 (yield gpm) (type power)
- (7) electric log No (yes or no)

(organization running log)

(8) how well bottom plugged
L. H. H. H. H. H.

DRILLERS REMARKS:


DEPT. OF NATURAL RESOURCES
BUREAU OF LAND & WATER RESOURCES

JAN 21 1981

RECEIVED

If well telescopes please sketch and show depths.

GROUND LEVEL

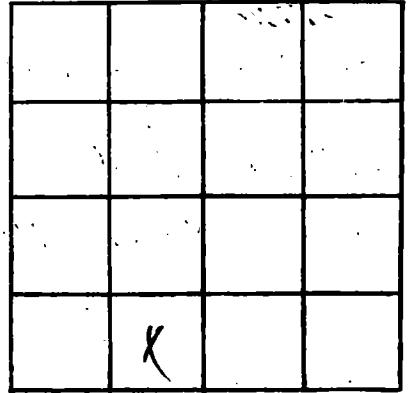

SECTION _____

Please indicate well location X.

ADDITIONAL INFORMATION

If more than one screen, show locations of each on sketch.