

MISSISSIPPI DEPARTMENT OF NATURAL RESOURCES

Bureau of Land and Water Resources

Southport Mall

P.O. Box 10631

Jackson, Mississippi 39209

WATER WELL DRILLERS LOG

COASTAL DRILLING & SERVICE CO.

JACKSON
N 2131
9-30-80

9/30/80
date well completed

ROUTE 1 BOX 618

Jackson
county well located

BILBO, MISS. 39552

LANDOWNER

description of formations encountered

from to

St 6 Box 59
Ocean Springs (mailing address)

Top Soil	1	3
Red Clay	3	20
Comp. White Sand	20	45
S.H. Blue Clay	45	210
hard Blue Clay	210	370
fine white sand	370	400
good water sand	400	420

WELL LOCATION:

sec. 9 T 2 N R 8 E
(2) 1/2 miles (distance) South (direction) Ocean Springs (nearest town)

WELL PURPOSE:

home (home, irrigation, municipal, industrial)

WELL COMPLETION DATA:

- (1) diameter (inches) 2"
- (2) total depth (feet) 420'
- (3) static water level (feet) 4' below top of ground
- (4) casing PVC 4 1/2" (material) 410' (depth)
- (5) screen 10' 4 1/2" (length) (depth to top)
2" (size) PVC (material)
- (6) pump 1/2 (HP) 12 (yield gpm)
Gle (type power)
- (7) electric log no (yes or no)

(organization running log)

(8) how well bottom plugged
2" back wash drilled

DRILLERS REMARKS: 19-B


DEPT. OF NATURAL RESOURCES
BUREAU OF LAND AND WATER RESOURCES

JAN 15 1981

RECEIVED

If well telescopes please sketch and show depths.

GROUND LEVEL

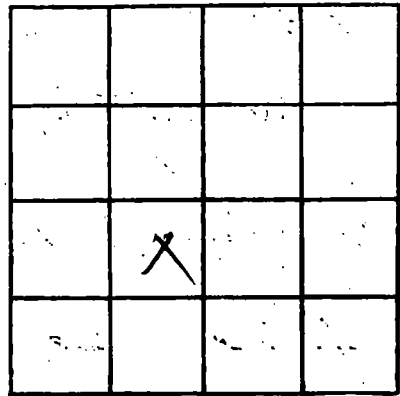

SECTION _____

Please indicate well location X.

ADDITIONAL INFORMATION

If more than one screen, show locations of each on sketch.