

MISSISSIPPI DEPARTMENT OF NATURAL RESOURCES

Bureau of Land and Water Resources

Southport Mall

P.O. Box 10631

Jackson, Mississippi 39209

WATER WELL DRILLERS LOG

JACKSON  
N 2137  
1-30-81

1-30-81 19 Cash Water Well Serv. Inc. Jackson  
date well completed firm name county well located

LANDOWNER Fabrica R. Patten  
8709 Meade St.  
Ocean Springs, Miss.  
(mailing address) 39564

WELL LOCATION:  
sec. 23 T N R 8  
3 miles E of Ocean Springs  
(distance) (direction) (nearest town)

WELL PURPOSE: Home  
(home, irrigation, municipal, industrial)

WELL COMPLETION DATA:  
(1) diameter (inches) 2"  
(2) total depth (feet) 476'  
(3) static water level (feet) 62' below top of ground.  
(4) casing PVC, 466'  
(size) (material) (depth)  
2" If telescope see back.  
(5) screen 10', 466'  
(length) (depth to top)  
2" PVC  
(size) (material)  
(6) pump 1/2 HP, 7  
(HP) (yield gpm)  
Elect.  
(type power)  
(7) electric log No.  
(yes or no)  
\_\_\_\_\_  
(organization running log)  
(8) How well bottom plugged?  
Backwash Valve

description of formations encountered	from	to
Top soil	0	5'
Blue Clay	5	70'
Blue Clay & streaked sand	70'	119'
gray med fine sand	119'	132'
Blue Clay	132'	184'
Blue fine sand	184'	330'
Blue Clay	330'	430'
Gray coarse sand	430'	476'

DEPT. OF NATURAL RESOURCES  
BUREAU OF LAND & WATER RESOURCES


APR - 6 1981

RECEIVED

DRILLERS REMARKS:

If well telescopes please sketch and show depths.

GROUND LEVEL

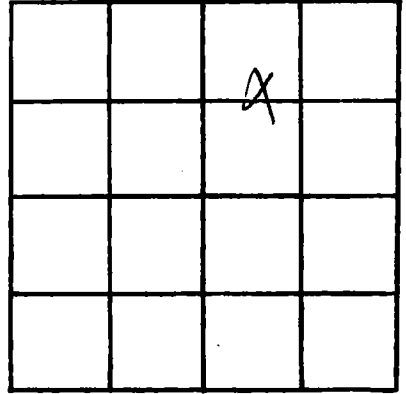

SECTION 23

Please indicate well location X.

ADDITIONAL INFORMATION

If more than one screen,  
show locations of each on sketch.