

MISSISSIPPI DEPARTMENT OF NATURAL RESOURCES

Bureau of Land and Water Resources

Southport Mall

P.O. Box 10631

Jackson, Mississippi 39209

WATER WELL DRILLERS LOG

JACKSON
N 2138
3-6-81

3-6
date well completed

1981 Duncan Well Drilling Jackson
firm name county well located

LANDOWNER: Philip Snoddy

description of formations encountered	from	to
sand	0	25
white clay	25	90
Blue clay	90	250
fine sand	250	262
Course sand	262	275

Box 6457

Biloxi, Mo.
(mailing address)

WELL LOCATION:

sec 18 T 7 N R 8 E
2 miles N of Bear Springs
(distance) (direction) (nearest town)

WELL PURPOSE: industrial
(home, irrigation, municipal, industrial)

WELL COMPLETION DATA:

- (1) diameter (inches) 2"
- (2) total depth (feet) 275 ft.
- (3) static water level (feet) 25' below top of ground.
- (4) casing PVC, 265'
(material) (depth)
- (5) screen 10', 265'
(length) (depth to top)
- 2" PVC
(size) (material)
- (6) pump 1 (HP) 17 (yield gpm)
electric
(type power)
- (7) electric log (yes or no)

(organization running log)

(8) how well bottom plugged sand
shank

DRILLERS REMARKS:


DEPT. OF NATURAL RESOURCES
BUREAU OF LAND & WATER RESOURCES

MAR 18 1981

RECEIVED

If well telescopes please sketch and show depths.

GROUND LEVEL

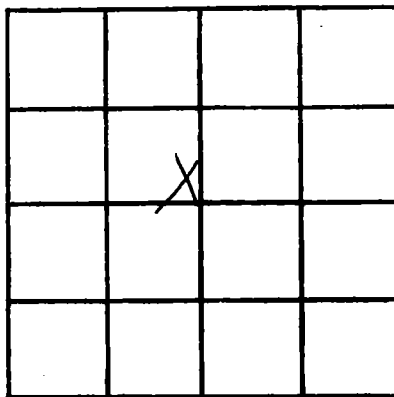

SECTION 18

Please indicate well location X.

ADDITIONAL INFORMATION

If more than one screen, show locations of each on sketch.