

MISSISSIPPI DEPARTMENT OF NATURAL RESOURCES

Bureau of Land and Water Resources

Southport Mall

P.O. Box 10631

Jackson, Mississippi 39209

WATER WELL DRILLERS LOG

COASTAL DRILLING & SERVICE CO.

ROUTE 1 BOX 618

county well located

DIXON, MISS. 39532

Jackson  
N 2140  
9-10-80  
9/10/80

date well completed 19

LANDOWNER

Earl Alley

Big Ridge Rd

Blacksburg

(mailing address)

WELL LOCATION:

sec. 10 T. 7 S. R. 9 W.  
(1) 0.0 mile South (S) West (W) of Blacksburg

WELL PURPOSE:

(home, irrigation, municipal, industrial) Home

WELL COMPLETION DATA:

- (1) diameter (inches) 2"
- (2) total depth (feet) 820'
- (3) static water level (feet) 35' below top of ground
- (4) casing PVC 805' (material) (depth) (size) If telescope see back.
- (5) screen 15' 805' (length) (depth to top) 2" PVC (size) (material)
- (6) pump One 15 (HP) (yield gpm) 5hp (type power)
- (7) electric log no (yes or no) (organization running log)

description of formations encountered

	from	to
top soil	1	3
Coarse white sand	3	25
Sugar sand	25	40
Soft blue clay	40	120
Coarse white sand	120	140
hard blue clay	140	240
Sugar sand	240	260
very hard blue clay	260	280
fine water sand	280	300
very hard blue clay	300	520
fine water sand	520	560
very hard blue clay	560	760
fine water sand	760	790
good water sand	790	820

DEPT. OF NATURAL RESOURCES  
BUREAU OF LAND & WATER RESOURCES

MAY 28 1981


RECEIVED

(8) how well bottom plugged

2" back wash valve  
DRILLERS REMARKS: 19 B

If well telescopes please sketch and show depths.

GROUND LEVEL

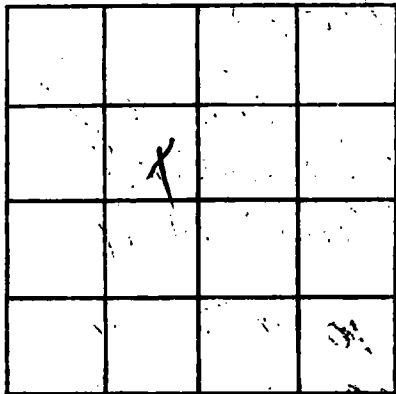

SECTION \_\_\_\_\_

Please indicate well location X.

ADDITIONAL INFORMATION

If more than one screen, show locations of each on sketch.