

MISSISSIPPI DEPARTMENT OF NATURAL RESOURCES

Bureau of Land and Water Resources

Southport Mall

P.O. Box 10631

Jackson, Mississippi 39209

WATER WELL DRILLERS LOG

JACKSON  
N 2104  
11-6-81

11-6-81 date well completed  
Coast & Water Well Serv. Inc. firm name  
Jackson county well located

LANDOWNER: James O. Lindsey  
P.O. Box 91  
Ocean Springs, Miss.  
(mailing address) 39564

description of formations encountered	from	to
Top soil	0	3'
Red clay	3'	10'
Blue clay	10'	104'
Blue clay to streak of sand	104'	119'
Blue clay	119'	220'
gray med sand	220'	230'

WELL LOCATION:  
sec. 18 T-7 S R-8 W  
1/4 miles (distance) of OCEAN SPRINGS (direction) of (nearest town)

WELL PURPOSE: None  
(home, irrigation, municipal, industrial)

- WELL COMPLETION DATA:
- (1) diameter (inches) 2"
  - (2) total depth (feet) 230'
  - (3) static water level (feet) 76' <sup>below</sup> ~~above~~ top of ground.
  - (4) casing PVC, 220' (material) (depth)  
2" (size) if telescope see back.
  - (5) screen 10' (length), 220' (depth to top)  
2" (size), PVC (material)
  - (6) pump 1/2 hp. (HP), 4 (yield gpm)  
Elec. (type power)
  - (7) electric log No- (yes or no)  
(organization running log)
  - (8) how well bottom plugged  
back wash valve

DRILLERS REMARKS:


DEPT. OF NATURAL RESOURCES  
BUREAU OF LAND & WATER RESOURCES

DEC 11 1981

RECEIVED

If well telescopes please sketch and show depths.

GROUND LEVEL

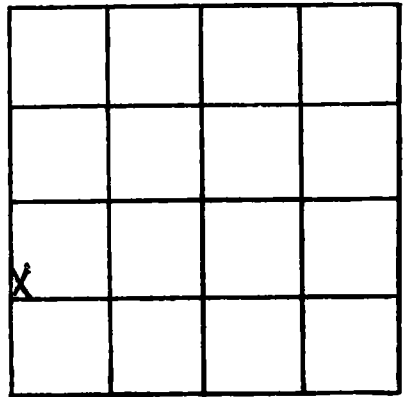

SECTION 18

Please indicate well location X.

ADDITIONAL INFORMATION

If more than one screen,  
show locations of each on sketch.