

MISSISSIPPI DEPARTMENT OF NATURAL RESOURCES

Bureau of Land and Water Resources

Southport Mall

P.O. Box 10631

Jackson, Mississippi 39209

WATER WELL DRILLERS LOG

COASTAL DRILLING & SERVICE CO.

ROUTE 1 BOX 618

county well located

BILOXI, MISS. 39532

JACKSON
N 2442
10-14-80
10/14/80

date well completed 19

LANDOWNER: Prof. Szwarc

description of formations encountered

from

to

Seaman Rd

top soil

1 3

Ocean Springs Min
(mailing address)

red clay

3 17

WELL LOCATION:

sec. 12 T. 7 N. R. 9 E

soft blue clay

17 40

2 1/2 miles WNW Shelby Miss

hard blue clay

40 145

(distance) (direction) (nearest town)

fine white sand

145 165

WELL PURPOSE: home
(home, irrigation, municipal, industrial)

gravel water sand

165 190

WELL COMPLETION DATA:

(1) diameter (inches) 2"

(2) total depth (feet) 190'

(3) static water level (feet) 20 (below/above top of ground)

(4) casing PVC 180'
(material) (depth)

(size) if telescope see back.

(5) screen 10' 180'
(length) (depth to top)

2" PVC
(size) (material)

(6) pump one 15
(HP) (yield gpm)

5hp
(type power)

(7) electric log no
(yes or no)

(organization running log)

(8) how well bottom plugged 2' bed wash valve

DRILLERS REMARKS:


DEPT. OF NATURAL RESOURCES
BUREAU OF LAND & WATER RESOURCES

MAY 28 1981

RECEIVED

If well telescopes please sketch and show depths.

GROUND LEVEL

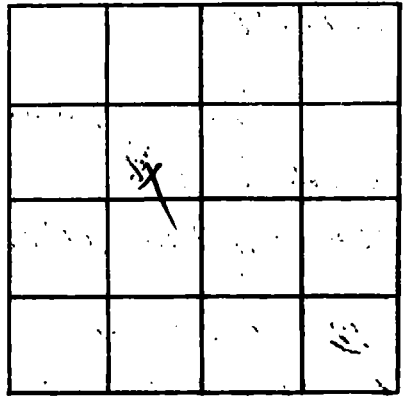

SECTION _____

Please indicate well location X.

ADDITIONAL INFORMATION

If more than one screen, show locations of each on sketch.