

MISSISSIPPI DEPARTMENT OF NATURAL RESOURCES

Bureau of Land and Water Resources

Southport Mall

P.O. Box 10631

Jackson, Mississippi 39209

COASTAL DRILLING & SERVICE CO. DRILLERS LOG

ROUTE 1 BOX 618

BILOXI, MISS. 39532

Joshua
county well located

N2143

12/30/81
date well completed

North Ocean Springs
Pt 2

North Ocean Springs, Miss
(mailing address)

WELL LOCATION:
sec. 13 T. 7 N. R. 9 E
2 1/2 miles North Ocean Springs
(distance) (direction) (nearest town)

WELL PURPOSE: home
(home, irrigation, municipal, industrial)

WELL COMPLETION DATA:

- (1) diameter (inches) 2"
- (2) total depth (feet) 240'
- (3) static water level (feet) 35' below top of ground.
- (4) casing px 230'
(material) (depth)
- (size) If telescope see back.
- (5) screen 10' 230'
(length) (depth to top)
- 2" px
(size) (material)
- (6) pump One 1/2 14 Gpm
(HP) (yield gpm)
- Ele
(type power)
- (7) electric log no
(yes or no)
- (organization running log)

(8) how well bottom plugged
2' bed with shale

DRILLERS REMARKS:

description of formations encountered	from	to
top soil	1	3
Red Clay	3	10
Soft Blue Clay	10	45
Coarse white sand	45	80
Soft Blue Clay	80	190
fine white sand	190	200
Hard Blue Clay	200	225
good water sand	225	240


DEPT. OF NATURAL RESOURCES
BUREAU OF LAND & WATER RESOURCES

JAN 15 1982

RECEIVED

If well telescopes please sketch and show depths.

GROUND LEVEL

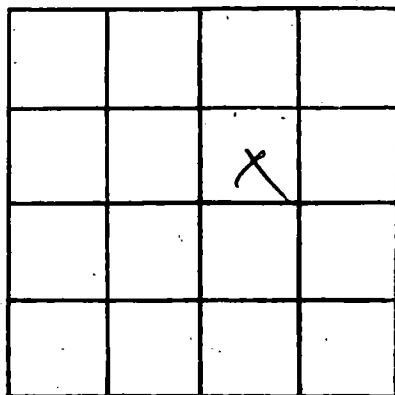

SECTION _____

Please indicate well location X.

ADDITIONAL INFORMATION

If more than one screen,
show locations of each on sketch.