

MISSISSIPPI DEPARTMENT OF NATURAL RESOURCES

Bureau of Land and Water Resources

Southport Mall

P.O. Box 10631

Jackson, Mississippi 39209

WATER WELL DRILLERS LOG
COASTAL DRILLING & SERVICE CO.

ROUTE 1 BOX 618

firm name

BILOXI, MISS. 39532

county well located

N 2144

1/21/81

date well completed

LANDOWNER

description of formations encountered

from

to

George M. White

et c
Charlynn Min
(mailing address)

Top Soil	1	3
Red Clay	3	15
Green Soil	15	60
Soft Blue Clay	60	180
fine water sand	180	190
shells	190	195
hard blue clay	195	265
fine water sand	265	275
Good water sand	275	290

WELL LOCATION:

sec. 13 T. 7 N. R. 9 E.
S W
Wave North Southcat
(distance) (direction) (nearest town)

WELL PURPOSE:

(home, irrigation, municipal, industrial)

WELL COMPLETION DATA:

- (1) diameter (inches) 2"
- (2) total depth (feet) 290
- (3) static water level (feet) 30' (below/above top of ground)
- (4) casing PVC 280'
(material) (depth)
- (size) if telescope see back.
- (5) screen 10' 280'
(length) (depth to top)
- 2" PVC
(size) (material)
- (6) pump one 14 gpm
(HP) (yield gpm)
- ele
(type power)
- (7) electric log no
(yes or no)

(organization running log)

(8) how well bottom plugged
2' below water

DRILLERS REMARKS:


DEPT. OF NATURAL RESOURCES
BUREAU OF LAND & WATER RESOURCES

JAN 15 1982

RECEIVED

If well telescopes please sketch and show depths.

GROUND LEVEL

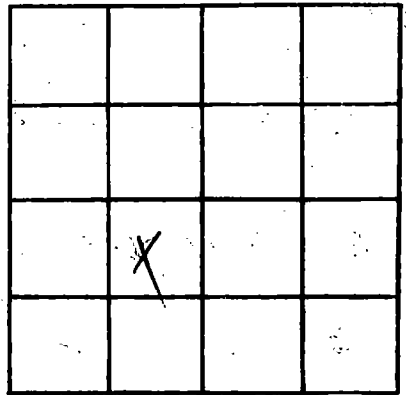

SECTION _____

Please indicate well location X.

ADDITIONAL INFORMATION

If more than one screen, show locations of each on sketch.