

MISSISSIPPI DEPARTMENT OF NATURAL RESOURCES

Bureau of Land and Water Resources

Southport Mall

P.O. Box 10631

Jackson, Mississippi 39209

COASTAL WATER WELL DRILLERS LOG

ROUTE 1 BOX 618

BILOXI, MISS firm name 39532

county well located

N 2445

10/20/81 19 date well completed

LANDOWNER: T. J. LeBlanc

description of formations encountered	from	to
top soil	1	3
Red Clay	3	15
Coarse white sand	15	60
Soft Blue Clay	60	240
fine water sand	240	245
Hard Blue Clay	245	460
fine water sand	460	490
Hard Blue Clay	490	765
fine water sand	765	830
fine water sand	830	850

12900 Spanish Ch.
Ocean Springs Min
(mailing address)

WELL LOCATION:

sec. 1 T. 7 N R. 9 E
2 1/2 miles (distance) North (direction) of Ocean Springs (nearest town)

WELL PURPOSE:

(home, irrigation, municipal, industrial) home

WELL COMPLETION DATA:

- (1) diameter (inches) 4 1/2"
- (2) total depth (feet) 850'
- (3) static water level (feet) 45' below top of ground
- (4) casing PVC 835' (material) (depth)
4 1/2" (size) if telescope see back.
- (5) screen 15' 835' (length) (depth to top)
2" (size) PVC (material)
- (6) pump 1/2 HP 18 gpm (HP) (yield/gpm)
3/4" (type power)
- (7) electric log no (yes or no)

(organization running log)

(8) how well bottom plugged:
2" backwash valve
DRILLERS REMARKS: sand seal

MISSISSIPPI DEPARTMENT OF NATURAL RESOURCES
BUREAU OF LAND & WATER RESOURCES

JAN 18 1982

RECEIVED

If well telescopes please sketch and show depths.

GROUND LEVEL


140'-4" casing
PVC

695'2" PVC casing

15'-2" PVC screen

2" back wash valve
sand seal

If more than one screen,
show locations of each on sketch.

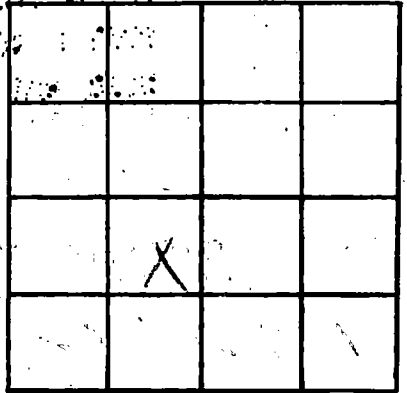

SECTION _____

Please indicate well location X.

ADDITIONAL INFORMATION

Lined area for additional information.