

MISSISSIPPI DEPARTMENT OF NATURAL RESOURCES

Bureau of Land and Water Resources

Southport Mall

P.O. Box 10631

Jackson, Mississippi 39209

COASTAL WATER WELL DRILLERS LOG  
& SERVICE CO.

ROUTE 1 BOX 618

BILOXI, MISS. 39537

*Jackson*  
county well located

N 2146

12/2/81  
date well completed 19

LANDOWNER: *Wayne Kite*  
*Coal Road Sundeep*  
*Oleor Spine min*  
(mailing address)

description of formations encountered	from	to
<i>Top Soil</i>	<i>1</i>	<i>4</i>
<i>Red Clay</i>	<i>4</i>	<i>20</i>
<i>Super Sand</i>	<i>20</i>	<i>45</i>
<i>Soft Blue Clay</i>	<i>45</i>	<i>210</i>
<i>Grey Water Sand</i>	<i>210</i>	<i>235</i>
<i>Good Water Sand</i>	<i>235</i>	<i>250</i>

WELL LOCATION:  
sec. *3* T. *7* R. *2*  
*Mill Creek*  
(distance) (direction) (nearest town)

WELL PURPOSE: *Home*  
(home, irrigation, municipal, industrial)

WELL COMPLETION DATA:  
(1) diameter (inches) *2"*  
(2) total depth (feet) *250'*  
(3) static water level (feet) *20'* *below*  
top of ground.  
(4) casing *PVC*, *240'*  
(material) (depth)  
(size) if telescope see back.  
(5) screen *10'*, *240'*  
(length) (depth to top)  
*2"*, *PVC*  
(size) (material)  
(6) pump *Oneil*, *14 Gpm*  
(HP) (yield gpm)  
*file*  
(type power)  
(7) electric log *no*  
(yes or no)  
(organization running log)

(8) how well bottom plugged  
*2" track with water*  
*Sand Seal*  
DRILLERS REMARKS


DEPT. OF NATURAL RESOURCES  
BUREAU OF LAND & WATER RESOURCES

JAN 18 1982

RECEIVED

If well telescopes please sketch and show depths.

GROUND LEVEL

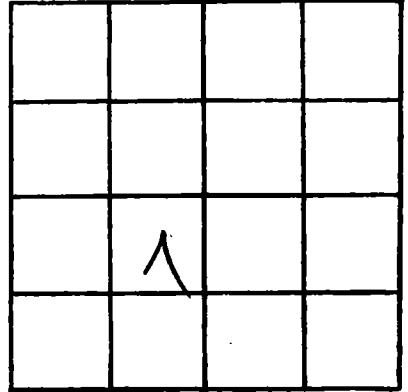

SECTION \_\_\_\_\_

Please indicate well location X.

ADDITIONAL INFORMATION

If more than one screen, show locations of each on sketch.