

MISSISSIPPI DEPARTMENT OF NATURAL RESOURCES

Bureau of Land and Water Resources

Southport Mall

P.O. Box 10631

Jackson, Mississippi 39209

WATER WELL DRILLERS LOG

Jackson  
2147

2-3-82  
date well completed

Coast Water Well Serv.  
firm name

Jackson  
county well located

LANDOWNER: Trend Concrete Co.

description of formations encountered

from to

P.O. Box 594  
Gautier, Miss.  
(mailing address) 39563

Top soil 0 7'

Red Clay 7' 19'

Blue Clay 19' 83'

Gray Coarse Sand 83' 125'

Blue Clay 125' 225'

Blue Clay & shell 225' 236'

of sand 236' 346'

Blue Clay 346' 355'

Gray Coarse sand 355' 437'

Blue Clay 437' 478'

Gray Coarse sand

WELL LOCATION:

sec. 13 T. 7 N. R. 8 E.  
3 miles (distance) NE (direction) of Green Springs (nearest town)

WELL PURPOSE: Home  
(home, irrigation, municipal, industrial)

WELL COMPLETION DATA:

(1) diameter (inches) 2"

(2) total depth (feet) 478'

(3) static water level (feet) 57' below top of ground.

(4) casing PVC (material), 468' (depth)

2" (size) If telescope see back.

(5) screen 10' (length), 468' (depth to top)

2" (size), PVC (material)

(6) pump 1hp. (HP), 7 1/2 (yield gpm)

Elect. (type power)

(7) electric log No. (yes or no)

(organization running log)

(8) back wash valve (how well bottom plugged)

DEPT. OF NATURAL RESOURCES  
BUREAU OF LAND & WATER RESOURCES


MAR 11 1982

RECEIVED

DRILLERS REMARKS:

If well telescopes please sketch and show depths.

GROUND LEVEL

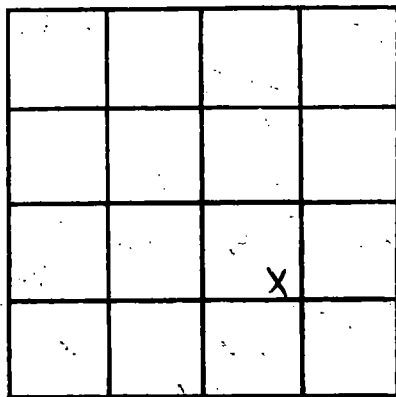

SECTION B3

Please indicate well location X.

ADDITIONAL INFORMATION

If more than one screen, show locations of each on sketch.