

MISSISSIPPI DEPARTMENT OF NATURAL RESOURCES

Bureau of Land and Water Resources

Southport Mall

P.O. Box 10631

Jackson, Mississippi 39209

WATER WELL DRILLERS LOG

Jackson
N2148

1-20-82 date well completed
Coast Water Well Sew. firm name
Jackson county well located

LANDOWNER: P. Ferguson
14205 Big Ridge Rd.
Ocean Springs, Miss.
(mailing address) 39564

description of formations encountered	from	to
Top soil	0	5'
Red med. sand	5'	19'
Red med sand & streak of clay	19'	40'
White coarse sand	40'	65'

WELL LOCATION:
sec. 12 T 7 S R 9 E
3 miles NW of Ocean Springs
(distance) (direction) (nearest town)

WELL PURPOSE: Home
(home, irrigation, municipal, industrial)

WELL COMPLETION DATA:

- (1) diameter (inches) 2"
- (2) total depth (feet) 65'
- (3) static water level (feet) 28' ^{below} ~~above~~ top of ground.
- (4) casing PVC, 55' (material), (depth)
2" (size) if telescope see back.
- (5) screen 10' (length), 55' (depth to top)
2" (size), PVC (material)
- (6) pump 3/4 (HP), 7 (yield gpm)
Elec. (type power)
- (7) electric log No. (yes or no)
(organization running log)

(8) How well bottom plugged
Backwash valve

DRILLERS REMARKS:


DEPT. OF NATURAL RESOURCES
BUREAU OF LAND & WATER RESOURCES

MAR 11 1982

RECEIVED

If well telescopes please sketch and show depths.

GROUND LEVEL

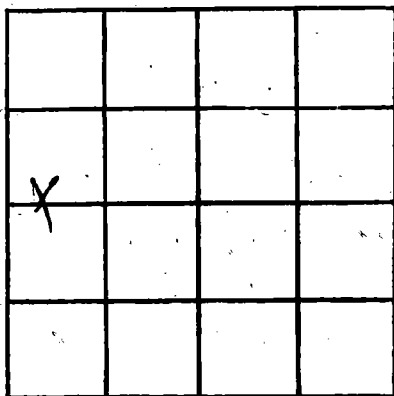

SECTION 12

Please indicate well location X.

ADDITIONAL INFORMATION

If more than one screen, show locations of each on sketch.