

MISSISSIPPI DEPARTMENT OF NATURAL RESOURCES

Bureau of Land and Water Resources

Southport Mall

P.O. Box 10631

Jackson, Mississippi 39209

WATER WELL DRILLERS LOG

Jackson
N2/S2

April 8 1982 Duncan Well Drilling Jackson
date well completed firm name county well located

LANDOWNER: Fred Kitch
9829 Scott Rd
Ocean Springs, Ms
(mailing address)

description of formations encountered	depth	
	from	to
<u>sand</u>	<u>0</u>	<u>25</u>
<u>clay</u>	<u>25</u>	<u>75</u>
<u>fine sand</u>	<u>75</u>	<u>80</u>
<u>course sand</u>	<u>80</u>	<u>100</u>

WELL LOCATION:
sec. 18 T. 7 N. R. 8 E.
2 miles N of Ocean Springs
(distance) (direction) (nearest town)

WELL PURPOSE: Home
(home, irrigation, municipal, industrial)

WELL COMPLETION DATA:

(1) diameter (inches) 2"

(2) total depth (feet) 100 ft.

(3) static water level (feet) 20' below top of ground.

(4) casing PVC 90'
(material) (depth)

(size) if telescope see back.

(5) screen 10' 90'
(length) (depth to top)

(size) 2" PVC
(size) (material)

(6) pump _____ (HP) _____ (yield gpm)
electric
(type power)

(7) electric log _____
(yes or no)

_____ (organization running log)

(8) how well bottom plugged hard
crack

DRILLERS REMARKS: owner had his own pump


DEPT. OF NATURAL RESOURCES
BUREAU OF LAND & WATER RESOURCES

AUG 30 1982

RECEIVED

If well telescopes please sketch and show depths.

GROUND LEVEL

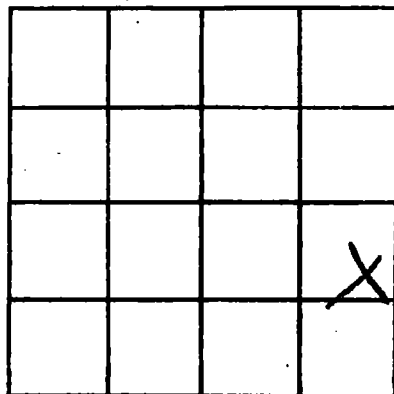

SECTION 18

Please indicate well location X.

ADDITIONAL INFORMATION

If more than one screen,
show locations of each on sketch.