

MISSISSIPPI DEPARTMENT OF NATURAL RESOURCES

Bureau of Land and Water Resources

Southport Mall

P.O. Box 10631

Jackson, Mississippi 39209

WATER WELL DRILLERS LOG

Jackson  
 No. 151

5-13-82 19 Coast Water Well Sew. Jackson  
 date well completed firm name county well located

LANDOWNER:

Charles Reinhardt

description of formations encountered

from

to

5917 Blithany Ave  
Biloxi, Miss 39530  
 (mailing address)

Top soil

0

3'

A. Clay

3'

27'

C. sand

27'

43'

B. Clay

43'

268'

M. sand

268'

295'

WELL LOCATION:

sec. 15 T. 7 N. R. 9 W.  
1 N miles (distance) (direction) of ST. MARTIN (nearest town)

WELL PURPOSE:

None  
 (home, irrigation, municipal, industrial)

WELL COMPLETION DATA:

- (1) diameter (inches) 2"
- (2) total depth (feet) 295'
- (3) static water level (feet) 40 <sup>below</sup>/<sub>above</sub> top of ground.
- (4) casing PVC 295'  
 (material) (depth)
- 2"  
 (size) If telescope see back.
- (5) screen 10' 285'  
 (length) (depth to top)
- 2" PVC  
 (size) (material)
- (6) pump 1/2 4  
 (HP) (yield gpm)
- check  
 (type power)
- (7) electric log No.  
 (yes or no)

(organization running log)

(8) back well bottom plugged  
backwash valve

DRILLERS REMARKS:


DEPT. OF NATURAL RESOURCES  
 BUREAU OF LAND & WATER RESOURCES

JUN - 4 1982

RECEIVED

If well telescopes please sketch and show depths.

GROUND LEVEL

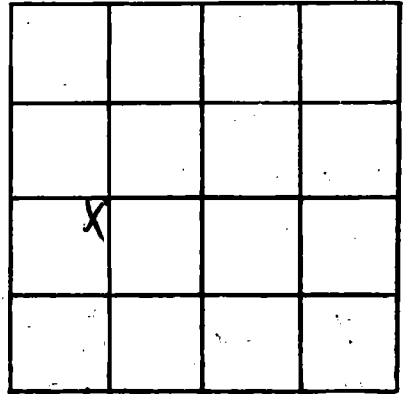

SECTION 15

Please indicate well location X.

ADDITIONAL INFORMATION

If more than one screen,  
show locations of each on sketch.