

MISSISSIPPI DEPARTMENT OF NATURAL RESOURCES

Bureau of Land and Water Resources

Southport Mall

P.O. Box 10631

Jackson, Mississippi 39209

WATER WELL DRILLERS LOG

Jackson  
 N2152

6-23 1982 date well completed  
 82 Coast Water Well Dr., Inc. firm name  
 Jackson county well located

LANDOWNER: Frank M. Eaton  
 Rt 7-Box 230  
 Ocean Springs, Miss.  
 (mailing address) 37564

WELL LOCATION:  
 sec. 2 T. 7 N. R. 9 E.  
 4 1/2 miles NW of Ocean Springs  
 (distance) (direction) (nearest town)

WELL PURPOSE:  
 (home, irrigation, municipal, industrial)

WELL COMPLETION DATA:  
 (1) diameter (inches) 2"  
 (2) total depth (feet) 424'  
 (3) static water level (feet) 75 below top of ground.  
 (4) casing PVC 4 1/4" (material) (depth)  
 2" (size) if telescope see back.  
 (5) screen 10' 4 1/4" (length) (depth to top)  
 2" PVC (material) (size)  
 (6) pump 1 h.p. 2 1/2 (HP) (yield gpm)  
 Elect. (type power)  
 (7) electric log No- (yes or no)  
 (organization running log)  
 (8) how well bottom plugged  
 Pack with valve

description of formations encountered	from	to
Top soil	0	3'
Red Clay	3'	10'
Blue Clay	10'	36'
White coarse sand & wood	36'	57'
Blue Clay	57'	325'
gray fine sand	325'	333'
Blue Clay & streak of sand	333'	382'
gray coarse sand	382'	424'

DEPT. OF NATURAL RESOURCES  
 BUREAU OF LAND & WATER RESOURCES


JUL 21 1982

RECEIVED

DRILLERS REMARKS:

If well telescopes please sketch and show depths.

GROUND LEVEL

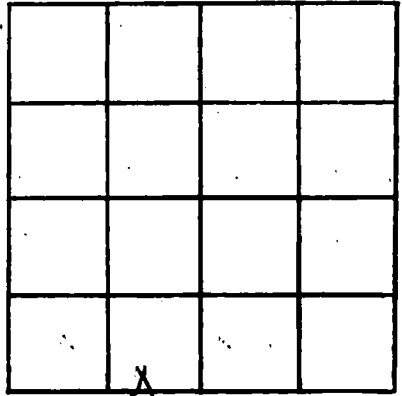

SECTION 2

Please indicate well location X.

ADDITIONAL INFORMATION

If more than one screen, show locations of each on sketch.