

MISSISSIPPI DEPARTMENT OF NATURAL RESOURCES

Bureau of Land and Water Resources

Southport Mall

P.O. Box 10631

Jackson, Mississippi 39209

WATER WELL DRILLERS LOG

Jackson  
N 2156

Aug. 13 1982 date well completed  
82 Duncan Well Drilling Jackson firm name  
Jackson county well located

LANDOWNER: Tommy Williams

Description of formations encountered	from	to
sand	0	40
Blue clay	40	60
Coarse sand	60	100

Ocean Springs, Mo.  
(mailing address)

WELL LOCATION:

sec 18 T 7 N R 8 E  
2 miles NW of Ocean Springs  
(distance) (direction) (nearest town)

WELL PURPOSE: Home  
(home, irrigation, municipal, industrial)

WELL COMPLETION DATA:

- (1) diameter (inches) 2"
- (2) total depth (feet) 100'
- (3) static water level (feet) 20' <sup>below</sup> ~~above~~ top of ground.
- (4) casing PVC, 90' (material), (depth)  
(size) if telescope see back.
- (5) screen 10', 90' (length), (depth to top)  
2" PVC (size), (material)
- (6) pump electric (HP), (yield gpm)  
(type power)
- (7) electric log (yes or no)

DEPT. OF NATURAL RESOURCES  
BUREAU OF LAND & WATER RESOURCES

(8) how well bottom plugged Sand  
Mark


DRILLERS REMARKS: Turner  
has his own  
pump

AUG 30 1982

RECEIVED

If well telescopes please sketch and show depths.

GROUND LEVEL

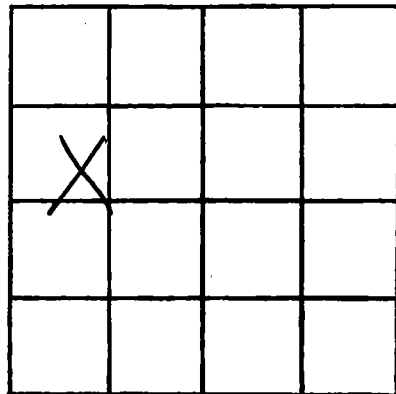

SECTION 18

Please indicate well location X.

ADDITIONAL INFORMATION

If more than one screen,  
show locations of each on sketch.