

MISSISSIPPI DEPARTMENT OF NATURAL RESOURCES

Bureau of Land and Water Resources

Southport Mall

P.O. Box 10631

Jackson, Mississippi 39209

WATER WELL DRILLERS LOG

Jackson  
N 2157

8-18-

82 Cash Water Well Sew.

Jackson

date well completed

firm name

county well located

LANDOWNER:

James A. Jackson

description of formations encountered

from

to

P.O. Box 177

Top soil

0 5'

Ocean Springs MS.

Red Clay

3' 18'

(mailing address) 39564

WELL LOCATION:

Blue Clay & Sandstone

18' 43'

sec 21 T 7 R 8

Blue Clay

43' 225'

IN miles (distance) — (direction) of OCEAN SPRINGS (nearest town)

Blue Clay & Sandstone

225' 234'

WELL PURPOSE:

Home  
(home, irrigation, municipal, industrial)

Blue clay

234' 360'

WELL COMPLETION DATA:

Blue Clay & Sandstone

360' 386'

(1) diameter (inches) 2"

Blue Clay

386' 420'

(2) total depth (feet) 475'

(3) static water level (feet) 66 <sup>below</sup> ~~above~~ top of ground.

gray, coarse sand

420' 475'

(4) casing PVC 4 65'  
(material) (depth)

2"  
(size) if telescope see back.

(5) screen 10' 465'  
(length) (depth to top)

2" PVC  
(size) (material)

(6) pump 1/2 HP —  
(HP) (yield gpm)

elect.  
(type power)

(7) electric log No.  
(yes or no)

(organization running log)

(8) how well bottom plugged Back Wash Valve

DRILLERS REMARKS:


DEPT. OF NATURAL RESOURCES  
BUREAU OF LAND & WATER RESOURCES

SEP 30 1982

RECEIVED

If well telescopes please sketch and show depths.

GROUND LEVEL

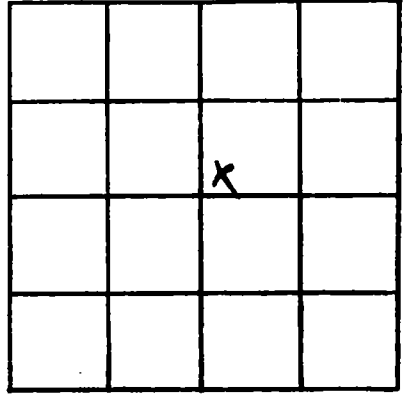

SECTION 21

Please indicate well location X.

ADDITIONAL INFORMATION

If more than one screen,  
show locations of each on sketch.