

MISSISSIPPI DEPARTMENT OF NATURAL RESOURCES

Bureau of Land and Water Resources

Southport Mall

P.O. Box 10631

Jackson, Mississippi 39209

WATER WELL DRILLERS LOG

Jackson
N 2458

8-31- 82. Coast Water Well Sew. Jackson
date well completed firm name county well located

LANDOWNER: Woodman of Wells
P.O. Box 461
Ocean Springs, Miss.
(mailing address) 39164

WELL LOCATION:
sec. 24 T. 7 N. R. 8 E.
(distance) 1 miles (direction) E of Ocean Springs (nearest town)

WELL PURPOSE: Home
(home, irrigation, municipal, industrial)

WELL COMPLETION DATA:

description of formations encountered	from	to
<u>Top soil</u>	<u>0</u>	<u>3'</u>
<u>L. Clay</u>	<u>3'</u>	<u>40'</u>
<u>M. Sand</u>	<u>40'</u>	<u>55'</u>
<u>B. Clay</u>	<u>55'</u>	<u>100'</u>
<u>M. Sand</u>	<u>100'</u>	<u>120'</u>

(1) diameter (inches) 2"
(2) total depth (feet) 120'
(3) static water level (feet) 20' below top of ground.
(4) casing PVC 110'
(material) (depth)
2" If telescope see back.
(size)
(5) screen 10' 110'
(length) (depth to top)
2" PVC
(size) (material)
(6) pump 1/2 hp. 6
(HP) (yield gpm)
Electric
(type power)
(7) electric log No.
(yes or no)
(organization running log)

(8) how well bottom plugged Backwash Valve

DRILLERS REMARKS:


DEPT. OF NATURAL RESOURCES
BUREAU OF LAND & WATER RESOURCES

SEP 30 1982

RECEIVED

If well telescopes please
sketch and show depths.

GROUND LEVEL

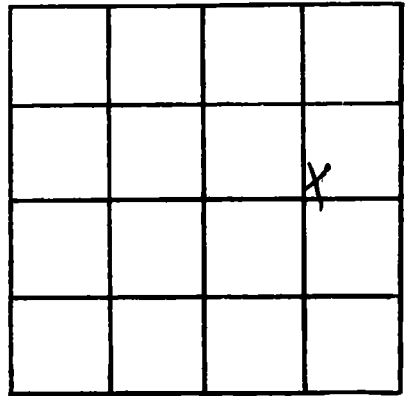

SECTION 24

Please indicate well location X.

ADDITIONAL INFORMATION

If more than one screen,
show locations of each on sketch.