

MISSISSIPPI DEPARTMENT OF NATURAL RESOURCES

Bureau of Land and Water Resources

Southport Mall

P.O. Box 10631

Jackson, Mississippi 39209

WATER WELL DRILLERS LOG
COASTAL DRILLING & SERVICE CO.

Jackson
N2159

12/28/82
date well completed

ROUTE 1 BOX 618
firm name

Jackson
county well located

BILLOM, MISS. 39532

LANDOWNER

description of formations encountered

from to

St. Morten
Biloxi, MS
(mailing address)

Top Soil	1	3
Red Clay	3	10
Coarse white Sand	10	35
Soft Blue Clay	35	90
fine water sand	90	110
Soft Blue Clay	110	205
Hard Blue Clay	205	260
fine water sand	260	285

WELL LOCATION:

sec. 12 T. 7 N. R. 9 E.
St. Morten
(distance) (direction) of (nearest town)

WELL PURPOSE:

(home, irrigation, municipal, industrial)

WELL COMPLETION DATA:

- (1) diameter (inches) 2"
- (2) total depth (feet) 295'
- (3) static water level (feet) 20' below top of ground.
- (4) casing PVC 285' (material) (depth)
- (5) screen 10' 285' (length) (depth to top)
- (6) pump 2" PVC 12 (size) (material) (HP) (yield gpm)
- (7) electric log No (yes or no)

(organization running log)

(8) how well bottom plugged


2' back with valve
DRILLERS REMARKS: 19-13

DEPT. OF NATURAL RESOURCES
BUREAU OF LAND & WATER RESOURCES

DEC-1 1992
RECEIVED

If well telescopes please sketch and show depths.

GROUND LEVEL

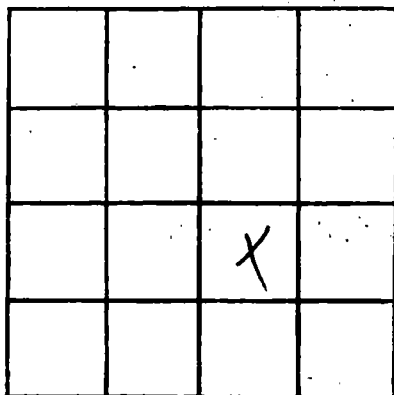

SECTION _____

Please indicate well location X.

ADDITIONAL INFORMATION

If more than one screen, show locations of each on sketch.