

MISSISSIPPI DEPARTMENT OF NATURAL RESOURCES

Bureau of Land and Water Resources

Southport Mall

P.O. Box 10631

Jackson, Mississippi 39209

COASTAL DRILLING & SERVICE CO. WATER WELL DRILLERS LOG

Jackson
N 216

ROUTE 1 BOX 618

Jackson

4/13/82
date well completed

BILOXI, MISS 39532
FLY name

county well located

LANDOWNER Jones, Spinner
Jusheuld Pt 6
Ocean Spring Min
(mailing address)

description of formations encountered	from	to
Top Soil	1	3
Red Clay	3	15
Soft Blue Clay	15	60
Super Sand	60	85
S.P.H. Blue Clay	85	190
Shells	190	200
Soft Blue Clay	200	290
Hard Blue Clay	290	370
fine water sand	370	420
good water sand	420	435

WELL LOCATION:
sec. 2 T 2 R 9 S 1 W
Inset A
(distance) (direction) of (nearest town)

WELL PURPOSE: home
(home, irrigation, municipal, industrial)


WELL COMPLETION DATA:
(1) diameter (inches) 2"
(2) total depth (feet) 435'
(3) static water level (feet) 60' below top of ground.
(4) casing PVC, 425' (material), (depth)
(size) If telescope see back.
(5) screen 10', 425' (length), (depth to top)
2" (size), PVC (material)
(6) pump 1/2 (HP), 12 (yield gpm)
Ele (type power)
(7) electric log no (yes or no)
(organization running log)

(8) how well bottom plugged
2" backfill
DRILLERS REMARKS: 19-8

RECEIVED
DEC 1 1982
BUREAU OF LAND & WATER RESOURCES
DEPT. OF NATURAL RESOURCES

If well telescopes please sketch and show depths.

GROUND LEVEL

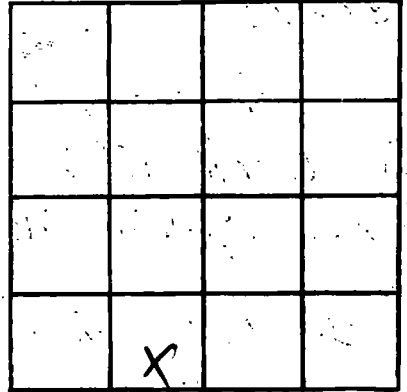

SECTION _____

Please indicate well location X.

ADDITIONAL INFORMATION

If more than one screen, show locations of each on sketch.