

MISSISSIPPI DEPARTMENT OF NATURAL RESOURCES

Bureau of Land and Water Resources

Southport Mall

P.O. Box 10631

Jackson, Mississippi 39209

COASTAL DRINKING WATER WELL DRILLERS LOG & SERVICE CO.

ROUTE 1 BOX 618

BILOXI, MISS. 39537

Jackson county well located

Jackson  
N 2163

5/28/82  
date/well completed

LANDOWNER: Gene Ishee

| description of formations encountered | from | to  |
|---------------------------------------|------|-----|
| Top Soil                              | 1    | 3   |
| Super Sand                            | 3    | 30  |
| Red Clay                              | 30   | 45  |
| Super Sand                            | 45   | 65  |
| Coarse white sand                     | 65   | 110 |
| Soft Blue Clay                        | 110  | 230 |
| fine white sand                       | 230  | 250 |
| Hard Blue Clay                        | 250  | 410 |
| good water sand                       | 410  | 440 |

PT 66

Ocean Springs  
(mailing address)

WELL LOCATION:

sec. 33 T. 7 R. 8  
1/2 mile North Ocean Springs  
(distance) (direction) (nearest town)

WELL PURPOSE:

(home, irrigation, municipal, industrial) home

WELL COMPLETION DATA:

- (1) diameter (inches) 2"
- (2) total depth (feet) 440
- (3) static water level (feet) 20 <sup>below</sup> top of ground.
- (4) casing PVC 430'  
(material) (depth)  
(size) If telescope see back.
- (5) screen 10' 430'  
(length) (depth to top)  
2" PVC  
(size) (material)
- (6) pump 1/2 14  
(HP) (yield gpm)  
5/8  
(type power)
- (7) electric log no  
(yes or no)  
(organization running log)


(8) has well bottom plugged no  
DRILLERS REMARKS: 17-5

DEPT. OF NATURAL RESOURCES  
BUREAU OF LAND AND WATER RESOURCES

DEC - 1 1982  
RECEIVED

If well telescopes please sketch and show depths.

GROUND LEVEL

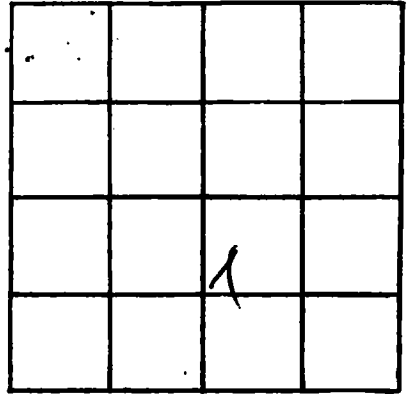

SECTION \_\_\_\_\_

Please indicate well location X.

ADDITIONAL INFORMATION

If more than one screen,  
show locations of each on sketch.