

Jackson  
N2167

MISSISSIPPI DEPARTMENT OF NATURAL RESOURCES  
Bureau of Land and Water Resources  
Southport Mall  
P.O. Box 10631  
Jackson, Mississippi 39209  
WATER WELL DRILLERS LOG

Oct 17 1982 Proden Pump & Well Co. Jackson  
date well completed firm name county well located

LANDOWNER: Myrtle Koton  
6105 Le Poma  
Biloxi, Miss. 39523  
(mailing address)

WELL LOCATION:  
sec. 19 T. 7 S. R. 9 E.  
In miles Delbert of Delbert  
(distance) (direction) (nearest town)

WELL PURPOSE: Home  
(home, irrigation, municipal, industrial)

WELL COMPLETION DATA:

(1) diameter (inches) 2 1/2

(2) total depth (feet) 340

(3) static water level (feet) 36 (below/above top of ground)

(4) casing PVC 330  
(material) (depth)

27  
(size) If telescope see back.

(5) screen 10ft 330  
(length) (depth to top)

2" PVC  
(size) (material)

(6) pump 1 12  
(HP) (yield gpm)

110V 1Ø  
(type power)

(7) electric log No  
(yes or no)

(organization running log)

(8) how well bottom plugged  
2" Sand Shark


description of formations encountered	from	to
<u>Clay</u>	<u>0</u>	<u>40</u>
<u>Sand</u>	<u>40</u>	<u>45</u>
<u>Clay</u>	<u>45</u>	<u>60</u>
<u>Sand</u>	<u>60</u>	<u>68</u>
<u>Blue Clay</u>	<u>68</u>	<u>120</u>
<u>Sand &amp; Clay Layers</u>	<u>120</u>	<u>130</u>
<u>Blue Clay</u>	<u>130</u>	<u>140</u>
<u>Sand</u>	<u>140</u>	<u>185</u>
<u>Blue Clay</u>	<u>185</u>	<u>220</u>
<u>Sand &amp; Clay Layers</u>	<u>220</u>	<u>240</u>
<u>Fine Sand</u>	<u>240</u>	<u>260</u>
<u>Blue Clay</u>	<u>260</u>	<u>315</u>

DEPT. OF NATURAL RESOURCES  
BUREAU OF LAND & WATER RESOURCES  
OCT 25 1982  
**RECEIVED**

DRILLERS REMARKS:

If well telescopes please sketch and show depths.

GROUND LEVEL

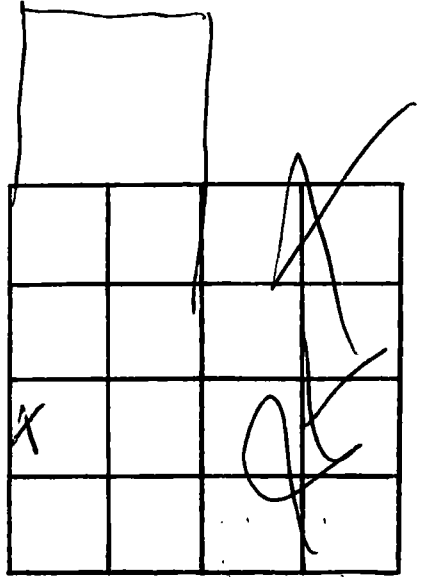

SECTION 16

Please indicate well location X.

ADDITIONAL INFORMATION

If more than one screen, show locations of each on sketch.