

MISSISSIPPI DEPARTMENT OF NATURAL RESOURCES

Bureau of Land and Water Resources

Southport Mall

P.O. Box 10631

Jackson, Mississippi 39209

WATER WELL DRILLERS LOG

Jackson  
N 2169

1-17-83 19 Coast Water Well Sewer Jackson  
date well completed firm name county well located

LANDOWNER: Deborah Hulse

306 Sherwin Dr.  
Biloxi, Miss. 39537  
(mailing address)

WELL LOCATION:  
sec. 9 T. 7 N R. 8 W  
2 miles N of OCEAN SPRING  
(distance) (direction) (nearest town)

WELL PURPOSE: None  
(home, irrigation, municipal, industrial)

WELL COMPLETION DATA:

- (1) diameter (inches) 2"
- (2) total depth (feet) 180'
- (3) static water level (feet) 35 <sup>below</sup>/<sub>above</sub> top of ground.
- (4) casing PVC 170'  
(material) (depth)  
2" if telescope see back.  
(size)
- (5) screen 10' 170'  
(length) (depth to top)  
2" PVC  
(size) (material)
- (6) pump 1/2 5 1/2  
(HP) (yield gpm)  
Club  
(type power)
- (7) electric log no  
(yes or no)  
no  
(organization running log)

| Description of formations encountered | from        | to          |
|---------------------------------------|-------------|-------------|
| <u>M. Sand</u>                        | <u>0</u>    | <u>28'</u>  |
| <u>B. Clay</u>                        | <u>28'</u>  | <u>42'</u>  |
| <u>M. Sand</u>                        | <u>42'</u>  | <u>77'</u>  |
| <u>B. Clay</u>                        | <u>77'</u>  | <u>158'</u> |
| <u>M. Sand</u>                        | <u>158'</u> | <u>180'</u> |

DEPT. OF NATURAL RESOURCES  
BUREAU OF LAND & WATER RESOURCES

FEB 18 1983


RECEIVED

(8) how well bottom plugged Back Wash Valve

DRILLERS REMARKS:

If well telescopes please sketch and show depths.

GROUND LEVEL

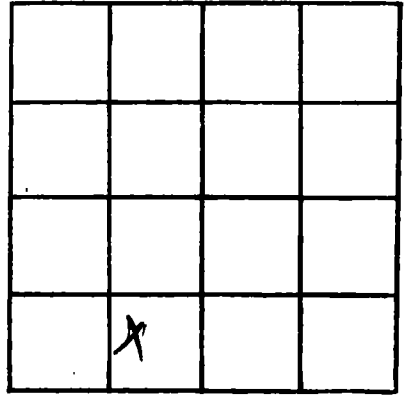

SECTION 9

Please indicate well location X.

ADDITIONAL INFORMATION

If more than one screen,  
show locations of each an sketch.