

MISSISSIPPI DEPARTMENT OF NATURAL RESOURCES

Bureau of Land and Water Resources

Southport Mall

P.O. Box 10631

Jackson, Mississippi 39209

WATER WELL DRILLERS LOG

Jackson
N 2170

2-4-83

Coast Water Well Sew. Jackson

date well completed

firm name

county well located

LANDOWNER:

Waffle House
P.O. Box 6450
Norcross GA. 30091
(mailing address)

description of formations encountered

from

to

Top soil	0	1'
Red clay	1'	17'
Blue clay	17'	48'
Gray coarse sand	48'	62'
Blue clay	62'	193'
Blue clay & streak of sand	193'	220'
Blue clay	220'	260'
gray fine sand	260'	275'
Blue clay	275'	320'
Blue clay & streak of sand	320'	344'
gray coarse sand	344'	363'
Blue clay	363'	404'
gray coarse sand	404'	445'

WELL LOCATION:

sec. 12 T. 7 S. R. 9 E.
2 1/2 miles N of OCEAN SPRINGS
(distance) (direction) (nearest town)

WELL PURPOSE: Industrial
(home, irrigation, municipal, industrial)

WELL COMPLETION DATA:

- (1) diameter (inches) 4 1/2"
- (2) total depth (feet) 445'
- (3) static water level (feet) 25' below top of ground
- (4) casing PVC 425' (material) (depth)
- 4 1/2" (size) If telescope see back.
- (5) screen 20' 425' (length) (depth to top)
- 4 1/2" PVC (size) (material)
- (6) pump 1/2" 22 (type) (yield gpm)
- Elect. (type power)
- (7) electric log No (yes or no)

(organization running log)

(8) How well bottom plugged
back wash valve

DRILLERS REMARKS:


DEPT. OF NATURAL RESOURCES
BUREAU OF LAND & WATER RESOURCES

APR 27 1983

RECEIVED

If well telescopes please sketch and show depths.

GROUND LEVEL

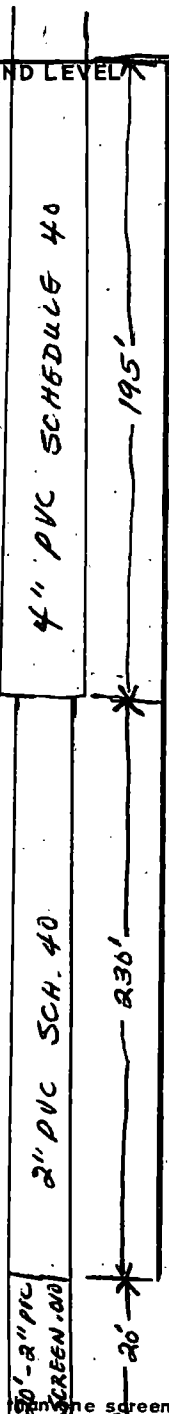

		X	

SECTION 12

Please indicate well location X.

ADDITIONAL INFORMATION

If more than one screen, show locations of each on sketch.