

MISSISSIPPI DEPARTMENT OF NATURAL RESOURCES

Bureau of Land and Water Resources

Southport Mall

P.O. Box 10631

Jackson, Mississippi 39209

WATER WELL DRILLERS LOG

Jackson
N2911

2-11-83 date well completed
83 Coast Water Well Sew. firm name
Jackson county well located

LANDOWNER: Jay Shenk
7508 Tapp Rd.
Ocean Springs, Miss
(mailing address) 39564

description of formations encountered	from	to
<u>Sandy Top soil</u>	<u>0</u>	<u>27'</u>
<u>B. Clay</u>	<u>27'</u>	<u>30'</u>
<u>M. Sand</u>	<u>30'</u>	<u>57'</u>
<u>B. Clay</u>	<u>57'</u>	<u>96'</u>
<u>M. Sand</u>	<u>96'</u>	<u>120'</u>

WELL LOCATION:
sec 24 T 7 R 8
3 miles ENE of OCEAN SPRINGS
(distance) (direction) (nearest town)

WELL PURPOSE: Home
(home, irrigation, municipal, industrial)

WELL COMPLETION DATA:

(1) diameter (inches) 2"

(2) total depth (feet) 120'

(3) static water level (feet) 19' (below top of ground)

(4) casing PVC 110'
(material) (depth)
2"
(size) if telescope see back.

(5) screen 10' 110'
(length) (depth to top)
2" PVC
(size) (material)

(6) pump — —
(HP) (yield gpm)
Elect.
(type power)

(7) electric log No.
(yes or no)

—
(organization running log)

(8) How well bottom dug?
Back was dug

DRILLERS REMARKS:


DEPT. OF NATURAL RESOURCES
BUREAU OF LAND & WATER RESOURCES

APR 27 1983

RECEIVED

If well telescopes please sketch and show depths.

GROUND LEVEL

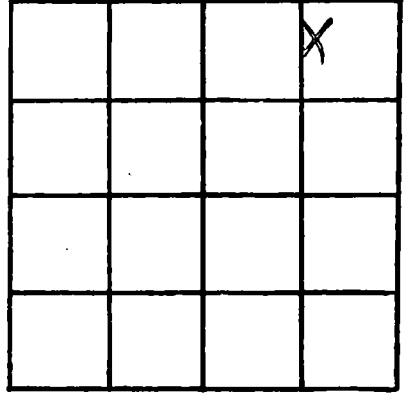

SECTION 24

Please indicate well location X.

ADDITIONAL INFORMATION

If more than one screen, show locations of each on sketch.