

MISSISSIPPI DEPARTMENT OF NATURAL RESOURCES

Bureau of Land and Water Resources

Southport Mall

P.O. Box 10631

Jackson, Mississippi 39209

WATER WELL DRILLERS LOG

Jackson
 No. 172

3-14 1983 date well completed
 83 Coast Water Well Sew. firm name
 Jackson county well located

LANDOWNER:

John Anglada
 13301 Sunnyside Ave
 Ocean Springs, Miss.
 (mailing address) 39564

description of formations encountered

from to

Top soil & clay	0	15'
Blue clay	15'	60'
sand & gravel	60'	65'
Blue clay	65'	100'
sand-fine-med	100'	125'
Blue clay	125'	250'
sand med. fine	250'	255'
Blue sand clay	255'	435'
sand med.	432'	450'
sand fine	450'	465'
fine sand & clay	465'	470'

WELL LOCATION:

sec. 13 T. 7 N. R. 9 E. W. 6
 1 miles NW of OCEAN SPRINGS
 (distance) (direction) (nearest town)

WELL PURPOSE:

Home (home, irrigation, municipal, industrial)

WELL COMPLETION DATA:

- (1) diameter (inches) 2"
- (2) total depth (feet) 470
- (3) static water level (feet) 86' below top of ground.
- (4) casing PVC, 455' (material), (depth)
 2" (size) if telescope see back.
- (5) screen 15, 455' (length), (depth to top)
 2" (size), PVC (material)
- (6) pump (HP) (yield gpm)
 Elect. (type power)
- (7) electric log No. (yes or no)

(organization running log)

(8) how well bottom plugged
 vac & wash valve

DRILLERS REMARKS:


DEPT. OF NATURAL RESOURCES
 BUREAU OF LAND & WATER RESOURCES

APR 28 1983

RECEIVED

If well telescopes please sketch and show depths.

GROUND LEVEL

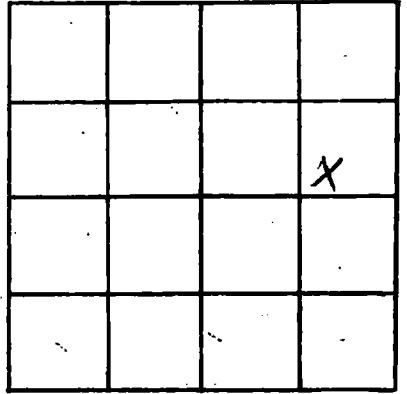

SECTION 13

Please indicate well location X.

ADDITIONAL INFORMATION

If more than one screen, show locations of each on sketch.