

MISSISSIPPI DEPARTMENT OF NATURAL RESOURCES

Bureau of Land and Water Resources

Southport Mall

P.O. Box 10631

Jackson, Mississippi 39209

WATER WELL DRILLERS LOG  
COASTAL DRILLING & SERVICE CO.

Jackson  
N 2174

2/1/83 19  
date well completed

ROUTE 1 BOX 618  
firm name

Jackson  
county well located

LANDOWNER: T. L. Moody  
Jenn. Out. St.  
Ocean Springs, Ms  
(mailing address)

BILOXI, MISS. 39532

description of formations encountered

description of formations encountered	from	to
Top Soil	1	5
White Sand	5	20
Soft Blue Clay	20	60
Brown Sand	60	85
Shell	85	90
Soft Blue Clay	90	380
fine water sand	380	410
hard water sand	410	430

WELL LOCATION:  
sec. 2-3 T. 7 N R. 8 E  
Wane, North Hwy 90  
(distance) (direction) (nearest town)

WELL PURPOSE: home  
(home, irrigation, municipal, industrial)

WELL COMPLETION DATA:

(1) diameter (inches) 2"

(2) total depth (feet) 430'

(3) static water level (feet) 40' below top of ground

(4) casing 4" (material) 430' (depth)

(size) If telescope see back.

(5) screen 10' (length) 420' (depth to top)

2" (size) PVC (material)

(6) pump Wane (HP) 12 (yield gpm)

ele (type power)

(7) electric log no (yes or no)

(organization running log)

(8) how well bottom plugged  
2" pack water valve  
DRILLERS REMARKS: 198


DEPT. OF NATURAL RESOURCES  
BUREAU OF LAND & WATER RESOURCES

AUG 15 1983

RECEIVED

If well telescopes please sketch and show depths.

GROUND LEVEL

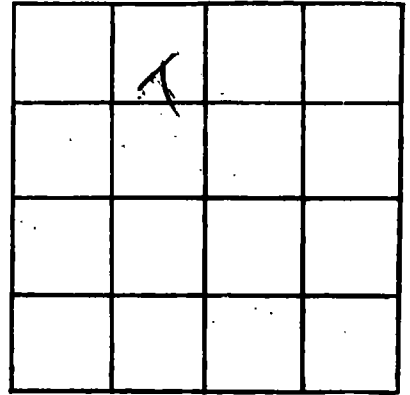

SECTION \_\_\_\_\_

Please indicate well location X.

ADDITIONAL INFORMATION

If more than one screen,  
show locations of each on sketch.