

MISSISSIPPI DEPARTMENT OF NATURAL RESOURCES

Bureau of Land and Water Resources

Southport Mall

P.O. Box 10631

Jackson, Mississippi 39209

WATER WELL DRILLERS LOG

Jackson
N 2176

4-23-19
date well completed

83 Coast Water Well Sew. Jackson.
firm name county well located

LANDOWNER: George P. Hering
7120 1st Bayou Road
Ocean Springs, Miss.
(mailing address)

Description of formations encountered	from	to
Top soil	0	10'
Red Clay	10'	22'
Red coarse sand & gravel	22'	65'
Blue Clay & streaks of sand	65'	100'
Blue Clay	100'	130'
Blue fine sand	130'	190'
Blue Clay	190'	194'
Blue Clay & gravel	194'	397'
Gray med sand	397'	430'

WELL LOCATION:
sec. 8 T. 1 R. 8 E.
2 miles (distance) N of OCEAN SPRINGS (nearest town)

WELL PURPOSE: Home
(home, irrigation, municipal, industrial)

WELL COMPLETION DATA:
(1) diameter (inches) 2"
(2) total depth (feet) 430'
(3) static water level (feet) 76' (below top of ground)
(4) casing PVC 420' (material), (depth)
2" (size) If telescope see back.
(5) screen 10' (length), 420' (depth to top)
2" (size), PVC (material)
(6) pump 1 hp. (HP), 5 1/2 (yield gpm)
Elec. (type power)
(7) electric log No. (yes or no)
(organization running log)

(8) How well bottom plugged:
Backwash Valve

DRILLERS REMARKS:


DEPT. OF NATURAL RESOURCES
BUREAU OF LAND & WATER RESOURCES

JUN 24 1983

RECEIVED

If well telescopes please sketch and show depths.

GROUND LEVEL

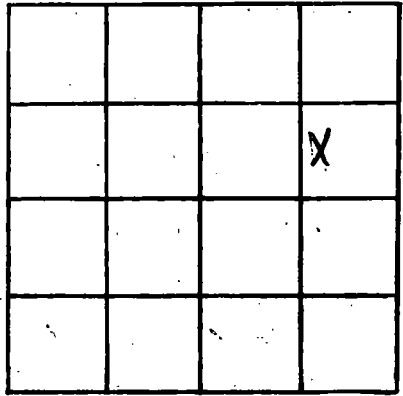

SECTION 8

Please indicate well location X.

ADDITIONAL INFORMATION

If more than one screen,
show locations of each on sketch.