

MISSISSIPPI DEPARTMENT OF NATURAL RESOURCES

Bureau of Land and Water Resources

Southport Mall

P.O. Box 10631

Jackson, Mississippi 39209

WATER WELL DRILLERS LOG

Jackson
N2177

5-4-83
date well completed

Cross Water Well Sew.
firm name

Jackson
county well located

LANDOWNER:

Phyllis Williamson
7501 Old Mt. Zion Rd.
102 Buehly Dr.
Ocean Springs Miss.
(mailing address) 39564

description of formations encountered

description of formations encountered	from	to
Top soil & Red Clay	0	20'
Blue Clay	20'	100'
Fine Blue Sand	100'	205'
Blue Clay	205'	344'
Fine Med. to Coarse Sand	344'	387'

WELL LOCATION:

sec. 8 T. 7 S. R. 8 W.
2 miles N of OCEAN SPRINGS
(distance) (direction) (nearest town)

WELL PURPOSE:

Home
(home, irrigation, municipal, industrial)

WELL COMPLETION DATA:

- (1) diameter (inches) 2"
- (2) total depth (feet) 387
- (3) static water level (feet) 70' below top of ground.
- (4) casing PVC, 377' (material) (depth)
- (size) 2" If telescope see back.
- (5) screen 10' 377' (length) (depth to top)
- (size) 2" (material) PVC
- (6) pump 1/2 HP, 6- (type power) (yield gpm)
- (7) electric log No. (yes or no)

(organization running log)

(8) how well bottom plugged
Back Wash Valve

DRILLERS REMARKS:


DEPT. OF NATURAL RESOURCES
BUREAU OF LAND & WATER RESOURCES

JUN 23 1983

RECEIVED

If well telescopes please sketch and show depths.

GROUND LEVEL

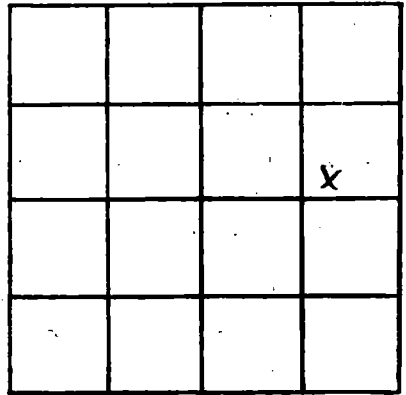

SECTION _____

Please indicate well location X.

ADDITIONAL INFORMATION

If more than one screen,
show locations of each on sketch.