

MISSISSIPPI DEPARTMENT OF NATURAL RESOURCES

Bureau of Land and Water Resources

Southport Mall

P.O. Box 10631

Jackson, Mississippi 39209

WATER WELL DRILLERS LOG

COASTAL DRILLING & SERVICE CO.

ROUTE 1 BOX 018

county well located

BILOXI, MISS. 39532

JACKSON
N 2180

12-22-80
12/22/80

date well completed 19

LANDOWNER

Carl Smith

old post rd

Oleen Spring Miss

(mailing address)

WELL LOCATION:

sec. T-7 R. 9-E

Mill Creek
(distance) (direction) of (nearest town)

WELL PURPOSE:

(home, irrigation, municipal, industrial) home

WELL COMPLETION DATA:

- (1) diameter (inches) 2"
- (2) total depth (feet) 390'
- (3) static water level (feet) 40' ^{below} _{above} top of ground.
- (4) casing PVC, 380',
(material) (depth)
(size) if telescope see back.
- (5) screen 10', 380'
(length) (depth to top)
2", PVC
(size) (material)
- (6) pump one, 12
(HP) (yield gpm)
ELC
(type power)
- (7) electric log no
(yes or no)

(organization running log)

(8) how well bottom plugged

2" back wash valve

DRILLERS REMARKS: 19-b

description of formations encountered

from to

top soil	1	3
red clay	3	15
white sand	15	60
soft blue clay	60	320
hard blue clay	320	340
fine water sand	340	370
coarse water sand	370	390


DEPT. OF NATURAL RESOURCES
BUREAU OF LAND & WATER RESOURCES

MAY 28 1981

RECEIVED

If well telescopes please sketch and show depths.

GROUND LEVEL

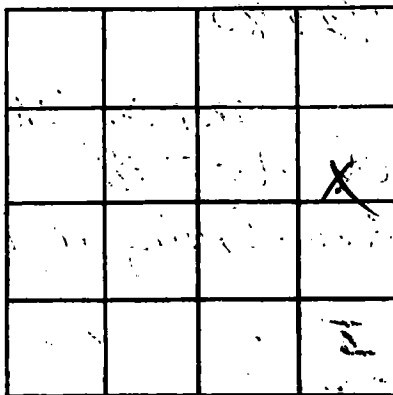

SECTION _____

Please indicate well location X.

ADDITIONAL INFORMATION

If more than one screen, show locations of each on sketch.