

MISSISSIPPI DEPARTMENT OF NATURAL RESOURCES

Bureau of Land and Water Resources

Southport Mall

P.O. Box 10631

Jackson, Mississippi 39209

WATER WELL DRILLERS LOG  
COASTAL DRILLING & SERVICE CO.

ROUTE 1 BOX 618

BILOXI, MISS. 39532

county well located

JACKSON  
N 2181  
2-17-81

date well completed

LANDOWNER

Don Winter  
Del Ross Road  
Ocean Springs  
(mailing address)

description of formations encountered

from

to

top soil	1	3
white sand	3	25
gray sand	25	60
soft blue clay	60	210
fine water sand & shell	210	225
soft blue clay	225	300
hard blue clay	300	360
fine water sand	360	380
good water sand	380	400

WELL LOCATION:

sec 24 T 7 N R 2 E  
None miles north railroad  
(distance) (direction) (nearest town)

WELL PURPOSE:

(home, irrigation, municipal, industrial)

WELL COMPLETION DATA:

- (1) diameter (inches) 2"
- (2) total depth (feet) 400'
- (3) static water level (feet) 55' below top of ground
- (4) casing (material) PVC (depth) 390'
- (size) If telescope see back.
- (5) screen (length) 10' (depth to top) 390'
- (size) 2" (material) PVC
- (6) pump (HP) One (yield gpm) 10
- (type power) Ell
- (7) electric log (yes or no) No

(organization running log)

(8) how well bottom plugged

2' back with sludge

DRILLERS REMARKS:

19-B


DEPT. OF NATURAL RESOURCES  
BUREAU OF LAND & WATER RESOURCES

JUN 5 - 1981

RECEIVED

If well telescopes please sketch and show depths.

GROUND LEVEL

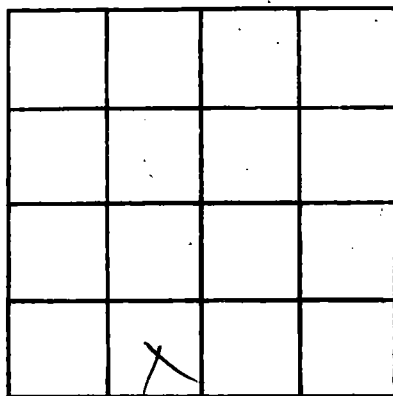

SECTION \_\_\_\_\_

Please indicate well location X.

ADDITIONAL INFORMATION

If more than one screen, show locations of each on sketch.