

MISSISSIPPI DEPARTMENT OF NATURAL RESOURCES

Bureau of Land and Water Resources

Southport Mall

P.O. Box 10631

Jackson, Mississippi 39209

WATER WELL DRILLERS LOG  
COASTAL DRILLING & SERVICE CO.

ROUTE 1 BOX 618 Jackson

firm BFDXL MISS 39632 county well located

Jackson  
N 2182  
3-30-81  
3/30/81

date well completed 19

LANDOWNER

Charles Short

description of formations encountered

from to

old post road  
Clear Spring Min  
(mailing address)

top soil	1	3
Red Clay	3	15
gravel sand	15	30
Coarse white sand	30	60
loam	60	65
Soft blue clay	65	210
fine water sand	210	320
light blue clay	220	310
hard blue clay	310	440
fine water sand	440	460
gravel water sand	460	480

WELL LOCATION:

sec. 1 T. 2 N. R. 9 E  
Will Creek  
(distance) (direction) of (nearest town)

WELL PURPOSE:

None  
(home, irrigation, municipal, industrial)


WELL COMPLETION DATA:

- (1) diameter (inches) 2"
- (2) total depth (feet) 480'
- (3) static water level (feet) 60' below above top of ground.
- (4) casing PVC 470' (material) (depth)
- (size) If telescope see back.
- (5) screen 10' 470' (length) (depth to top)
- 2" PVC (size) (material)
- (6) pump Orca 10 (HP) (yield gpm)
- 5hp (type power)
- (7) electric log No (yes or no)

(organization running log)

(8) how well bottom plugged  
2" lead with valve

DRILLERS REMARKS:

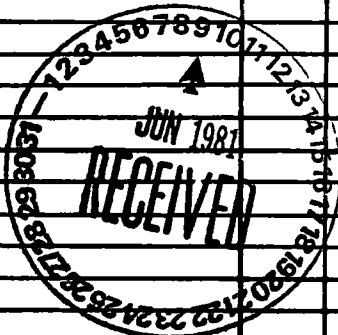

If well telescopes please sketch and show depths.

GROUND LEVEL


SECTION \_\_\_\_\_

Please indicate well location X.

ADDITIONAL INFORMATION

If more than one screen, show locations of each on sketch.