

MISSISSIPPI DEPARTMENT OF NATURAL RESOURCES

Bureau of Land and Water Resources

Southport Mall

P.O. Box 10631

Jackson, Mississippi 39209

WATER WELL DRILLERS LOG

Jackson
 N 2183
 4-14-81

4-14-81 date well completed
 Coastal Water Well Service, Inc. firm name
 Jackson county well located

LANDOWNER:

John E. Chitman
 760 1/2 Elm St.
 Biloxi, Miss.
 (mailing address) 39530

description of formations encountered

from to

WELL LOCATION:

sec. 12 T-7 N R-9 E
 2 miles N of Pagan Springs
 (distance) (direction) (nearest town)

Sandy Top soil	0	15'
B. Clay	15'	40'
C. sand	40'	55'
B. Clay	55'	105'
M. sand	105'	120'
B. Clay	120'	340'
M. sand	340'	370'

WELL PURPOSE:

(home, irrigation, municipal, industrial)
 home

WELL COMPLETION DATA:

- (1) diameter (inches) 2"
- (2) total depth (feet) 370'
- (3) static water level (feet) 45' (below top of ground)
- (4) casing PVC 360' (material) (depth)
- (5) screen 2" (size) If telescope see back.
- (6) screen 10' (length) 360' (depth to top)
- (7) pump 1 hp. 9 (HP) (yield gpm)
- (8) electric log (type power) Elect.
- (9) electric log No. (yes or no)

(organization running log)

(8) how well bottom plugged
 back wash valve

DRILLERS REMARKS:


DEPT. OF NATURAL RESOURCES
 BUREAU OF LAND & WATER RESOURCES

JUN 2 - 1981

RECEIVED

If well telescopes please sketch and show depths.

GROUND LEVEL

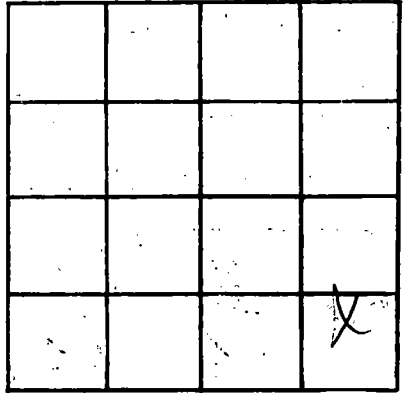

SECTION 12

Please indicate well location X.

ADDITIONAL INFORMATION

If more than one screen, show locations of each on sketch.