

MISSISSIPPI DEPARTMENT OF NATURAL RESOURCES

Bureau of Land and Water Resources

Southport Mall

P.O. Box 10631

Jackson, Mississippi 39209

WATER WELL DRILLERS LOG

COASTAL DRILLING & SERVICE CO.

JACKSON
N 2184
4-15-81
4/15/81

Date well completed 19

ROUTE BOX 618

county well located

LANDOWNER: T.T. Cantelero

MOULTRIE, MISS. 39552
description of formations encountered

from to

Lomez Bridge Road

top soil

1 3

Bilbo, Miss

Red Clay

3 18

(mailing address)

white sand

18 45

WELL LOCATION:

Soft Blue Clay

45 280

sec. 10 T. 7 N. R. 9 E
Town 4 South Latimer
(distance) miles (direction) of (nearest town)

fine water sand

280 295

good water sand

295 315

WELL PURPOSE: home
(home, irrigation, municipal, industrial)

WELL COMPLETION DATA:

- (1) diameter (inches) 2"
- (2) total depth (feet) 315'
- (3) static water level (feet) 30' below above top of ground
- (4) casing PVC 305'
(material) (depth)

(size) If telescope see back.


- (5) screen 10' 305'
(length) (depth to top)
- 2" PVC
(size) (material)
- (6) pump 1/2 HP 15
(HP) (yield gpm)
- cle
(type power)

- (7) electric log no
(yes or no)

(organization running log)

- (8) how well bottom plugged
2" back with water

DRILLERS REMARKS: A-B

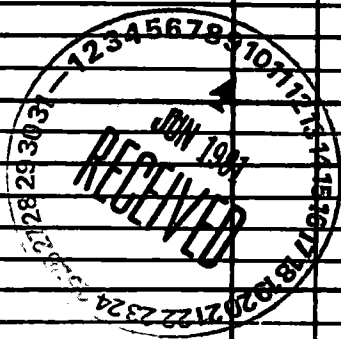

If well telescopes please sketch and show depths.

GROUND LEVEL

| | | | |
|----|----|----|----|
| 1 | 2 | 3 | 4 |
| 5 | 6 | 7 | 8 |
| 9 | 10 | 11 | 12 |
| 13 | 14 | 15 | 16 |

SECTION _____

Please indicate well location. X.

ADDITIONAL INFORMATION

If more than one screen, show locations of each on sketch.

Handwritten notes and signatures at the bottom of the page.