

MISSISSIPPI DEPARTMENT OF NATURAL RESOURCES

Bureau of Land and Water Resources

Southport Mall

P.O. Box 10631

Jackson, Mississippi 39209

WATER WELL DRILLERS LOG

JACKSON
N 2185
5/11/81
5-11-81

date well completed

firm name

county well located

Coast Water Well Serv. Inc. Jackson

LANDOWNER: Lee Landry
5914 Lepoma St.
Biloxi, Miss.
(mailing address) 39215-322

description of formations encountered

from


to

WELL LOCATION:
sec. 15 T. 7 R. 9
IN miles (distance) (direction) of ST. MARTIN
(nearest town)

Top soil 0' 2'
Red Clay 2' 15'
Red coarse sand 15' 35'
blue clay 35' 50'
blue fine sand 50' 70'
blue clay 70' 269'
gray med. sand 269' 290'

WELL PURPOSE: Home
(home, irrigation, municipal, industrial)

WELL COMPLETION DATA:
(1) diameter (inches) 2"
(2) total depth (feet) 280'
(3) static water level (feet) 44' below
top of ground.
(4) casing PVC, 270'
(material) (depth)
3" If telescope see back.
(size)
(5) screen 10', 270'
(length) (depth to top)
2", PVC
(size) (material)
(6) pump 1 hp., 8 1/2 -
(HP) (yield gpm)
Elect.
(type power)
(7) electric log No.
(yes or no)
(organization running log)
(8) How well bottom plugged
Backwash Valve

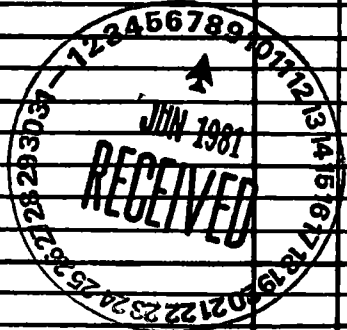

DRILLERS REMARKS:

