

Jackson
N 2187

MISSISSIPPI
BOARD OF WATER COMMISSIONERS
416 North State Street
Jackson, Mississippi 39201

WATER WELL DRILLERS LOG

6-12-81
6/12/81
date well completed

19 St Cecil S. Howells Jackson
firm name county well located


LANDOWNER: Stanley G. Horton
Sausauri Miss
(mailing address)

WELL LOCATION:
sec 23 T 7 N R 8 E
2 miles SW of Acorn
(distance) (direction) (nearest town)

WELL PURPOSE: Home
(home, irrigation, municipal, industrial)

- WELL COMPLETION DATA:
- (1) diameter (inches) 2"
 - (2) total depth (feet) 373
 - (3) static water level (feet) _____ below
top of ground above
 - (4) casing Plastic 373
(material) (depth)
 - _____ If telescope see back.
(size)
 - (5) screen 5ft 368
(length) (depth to top)
 - 2" Plastic
(size) (material)
 - (6) pump Electric 17
(type power) (yield (gpm))
 - (7) electric log _____
(yes or no)
 - _____ (organization running log)
 - (8) how well bottom plugged Back
wash valve

| description of formations encountered | from | to |
|---------------------------------------|------------|------------|
| | | |
| <u>Top soil</u> | <u>0</u> | <u>1</u> |
| <u>Black dirt</u> | <u>1</u> | <u>7</u> |
| <u>Red clay</u> | <u>7</u> | <u>30</u> |
| <u>Sand</u> | <u>30</u> | <u>51</u> |
| <u>Blue clay</u> | <u>51</u> | <u>71</u> |
| <u>Sand</u> | <u>71</u> | <u>105</u> |
| <u>Blue clay</u> | <u>105</u> | <u>120</u> |
| <u>Sand</u> | <u>120</u> | <u>331</u> |
| <u>Blue clay</u> | <u>331</u> | <u>373</u> |

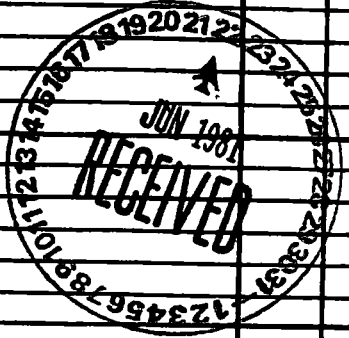

DRILLERS REMARKS:

If well telescopes please sketch and show depths.

GROUND LEVEL

| | | | |
|--|--|--|--|
| | | | |
| | | | |
| | | | |
| | | | |

SECTION

Please indicate well location X.

ADDITIONAL INFORMATION

Blank lines for additional information.



If more than one screen, show locations of each on sketch.