

MISSISSIPPI DEPARTMENT OF NATURAL RESOURCES

Bureau of Land and Water Resources

Southport Mall

P.O. Box 10631

Jackson, Mississippi 39209

WATER WELL DRILLERS LOG

JACKSON
N 2188
8-21-81

8-21-81 date well completed
St. Coast Water Well Serv. Inc. firm name
Jackson county well located

LANDOWNER: Dr. Albert Diaz
Ocean Springs
Miss. 39564
(mailing address)

description of formations encountered	from	to
Top soil	0	5'
Red Clay	5'	19'
Blue Clay	19'	75'
White Coarse Sand	75'	95'

WELL LOCATION:
sec 13 T 7 S R 8 E
4 miles NE of OCEAN SPRINGS
(distance) (direction) (nearest town)

WELL PURPOSE: Home
(home, irrigation, municipal, industrial)

WELL COMPLETION DATA:

(1) diameter (inches) 2"

(2) total depth (feet) 95'

(3) static water level (feet) flow-10' below ground
top of ground.

(4) casing 2" 90'
(material) (depth)

2" If telescope see back.
(size)

(5) screen 5' 90'
(length) (depth to top)

2" PVC
(size) (material)


(6) pump 1/2 8-
(HP) (yield gpm)

Elect.
(type power)

(7) electric log No-
(yes or no)

(organization running log)


(8) how well bottom plugged back wash valve

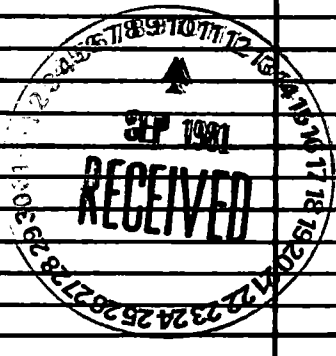

DRILLERS REMARKS:

If well telescopes please sketch and show depths.

GROUND LEVEL

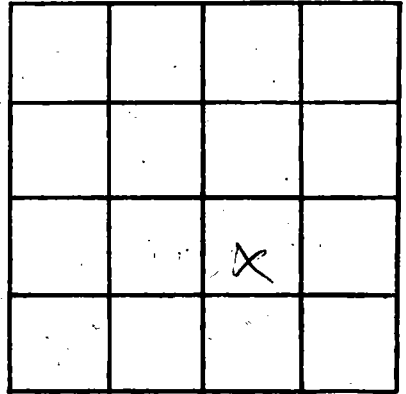

SECTION 13

Please indicate well location X.

ADDITIONAL INFORMATION

If more than one screen,
show locations of each on sketch.