

MISSISSIPPI DEPARTMENT OF NATURAL RESOURCES

Bureau of Land and Water Resources

Southport Mall

P.O. Box 10631

Jackson, Mississippi 39209

WATER WELL DRILLERS LOG

COASTAL DRILLING & SERVICE CO.

ROUTE 1 BOX 648

Jackson county well located

JACKSON  
N 2/89  
7-10-81

7/10/81  
date well completed 19

LANDOWNER: Del. DIXON MISS.  
St 6  
Ocean Spring Miss  
(mailing address)


description of formations encountered	from	to
<u>top soil</u>	<u>1</u>	<u>3</u>
<u>Red Clay</u>	<u>3</u>	<u>15</u>
<u>Coarse white sand</u>	<u>15</u>	<u>45</u>
<u>Soft Blue Clay</u>	<u>45</u>	<u>160</u>
<u>hard blue clay</u>	<u>160</u>	<u>210</u>
<u>fine white sand</u>	<u>210</u>	<u>235</u>

WELL LOCATION:  
sec. 13 T. 7 S. R. 8 W.  
St 6  
(distance) miles (direction) of (nearest town)

WELL PURPOSE: home  
(home, irrigation, municipal, industrial)

WELL COMPLETION DATA:


- (1) diameter (inches) 2"
- (2) total depth (feet) 235'
- (3) static water level (feet) 35' (below above top of ground)
- (4) casing PC 225'  
(material) (depth)  
(size) If telescope see back.
- (5) screen 10' 225'  
(length) (depth to top)  
2" PC  
(size) (material)
- (6) pump one 15  
(HP) (yield gpm)  
Elc  
(type power)
- (7) electric log no  
(yes or no)  
  
(organization running log)

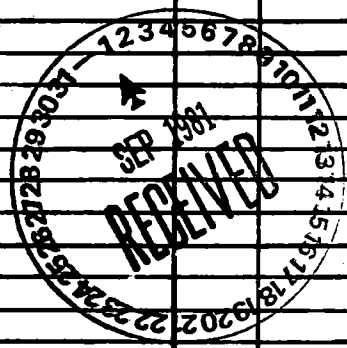

(8) how well bottom plugged  
2" bedrock  
DRILLERS REMARKS: 19-6

If well telescopes please sketch and show depths.

GROUND LEVEL

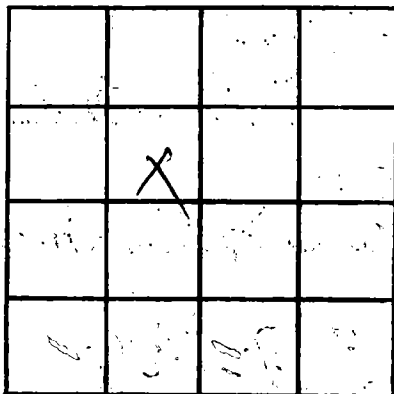

SECTION \_\_\_\_\_

Please indicate well location X.

ADDITIONAL INFORMATION

If more than one screen, show locations of each on sketch.