

MISSISSIPPI DEPARTMENT OF NATURAL RESOURCES

Bureau of Land and Water Resources

Southport Mall

P.O. Box 10631

Jackson, Mississippi 39209

WATER WELL DRILLERS LOG

JACKSON
N 2191
9-29-81

9-29-81
date well completed

Coast Water Well Serv. Inc.
firm name

Jackson
county well located

LANDOWNER: Mark A. Cox
Ph 6 - Box 148 W. Gay Rd.
Bidoxi, Miss. 39532
(mailing address)

description of formations encountered	from	to
Top soil	0	3'
Red Clay	3'	26'
White coarse sand & gravel	26'	44'
White clay & shub sand	44'	88'
Blue clay	88'	258'
Blue clay & shub sand	258'	345'
Gravel & wood	345'	375'
Grey coarse sand	375'	422'

WELL LOCATION:
sec. 1 T. 7 N. R. 9 E.
4 miles (distance) N (direction) of Osprey (nearest town)

WELL PURPOSE: Home
(home, irrigation, municipal, industrial)

- WELL COMPLETION DATA:
- (1) diameter (inches) 2"
 - (2) total depth (feet) 422'
 - (3) static water level (feet) 75' below top of ground.
 - (4) casing PVC (material), 412' (depth)
3" (size) If telescope see back.
 - (5) screen 10' (length), 412' (depth to top)
2" (size), PVC (material)
 - (6) pump 2hp (HP), 8 (yield gpm)
Electric (type power)
 - (7) electric log No (yes or no)
_____ (organization running log)
 - (8) How well bottom plugged Back Wash Valve

DEPT. OF NATURAL RESOURCES
BUREAU OF LAND & WATER RESOURCES


OCT 19 1981

RECEIVED

DRILLERS REMARKS:

If well telescopes please sketch and show depths.

GROUND LEVEL

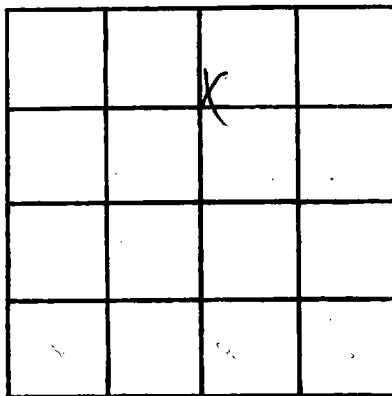

SECTION 1

Please indicate well location X.

ADDITIONAL INFORMATION

If more than one screen,
show locations of each on sketch.