

MISSISSIPPI DEPARTMENT OF NATURAL RESOURCES

Bureau of Land and Water Resources

Southport Mall

P.O. Box 10631

Jackson, Mississippi 39209

WATER WELL DRILLERS LOG

JACKSON  
N 2492  
10-28-81

10-28-81 19 Coast Water Well Sew. Jackson  
date well completed firm name county well located

LANDOWNER: Arnold Cancon  
1341 Coffeeville Rd  
Ocean Springs, Miss.  
(mailing address) 35168

description of formations encountered	from	to
Top soil	0	5'
Red Clay	5'	8'
Blue Clay	8'	40'
White Coarse sand & gravel	40'	110'
Blue Clay & Oyster Shell	110'	150'
Blue Clay	150'	325'
Gray Coarse sand	325'	357'

WELL LOCATION:  
sec. 12 T. 7 N. R. 9 E.  
3 miles (distance) NW (direction) of Ocean Springs (nearest town)

WELL PURPOSE: Home  
(home, irrigation, municipal, industrial)

WELL COMPLETION DATA:  
(1) diameter (inches) 2"  
(2) total depth (feet) 357'  
(3) static water level (feet) 77 below top of ground.  
(4) casing PVC (material) 347' (depth)  
2" (size) if telescope see back.  
(5) screen 10' (length) 347' (depth to top)  
2" (size) PVC (material)  
(6) pump 1 (HP) 4 1/2 (yield gpm)  
Electric (type power)  
(7) electric log No. (yes or no)  
— (organization running log)

(8) how well bottom plugged  
Back work. Value

DRILLERS REMARKS: —


DEPT. OF NATURAL RESOURCES  
BUREAU OF LAND & WATER RESOURCES

NOV 18 1981

RECEIVED

If well telescopes please sketch and show depths.

GROUND LEVEL

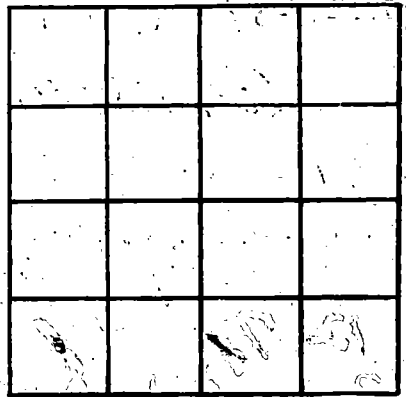

SECTION \_\_\_\_\_

Please indicate well location X.

ADDITIONAL INFORMATION

If more than one screen, show locations of each on sketch.